


WELL LOG BUREAU--KANSAS GEOLOGICAL SOCIETY
508 East Murdock, Wichita, Kansas

15-065-01665

Company- JONES, SHELburnE & FARMER, INC.
Farm- Sutor No. 2

SEC. 2 T. 10 R. 21W
NE SW NE
990' N of SL, 990' E of WL
NE $\frac{1}{4}$

Total Depth. 3854
Comm. 12-28-51 Comp. 1-14-52
Shot or Treated.
Contractor.
Issued. 6-7-52

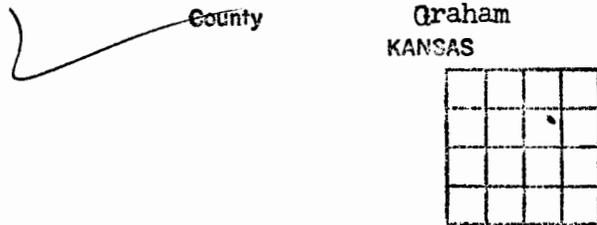

CASING:
8 5/8" 165' cem w/100 sx
5 1/2" 3900' cem w/100 sx

Elevation. 2292
2290 Ind.
Production. 201 bbls & no water

Figures Indicate Bottom of Formations.

shale, sand	150
shale	780
shale, streak sand	1100
shale, sand	1520
shale, red bed	1760
anhydrite	1805
shale, shells	2250
lime, shale	3280
lime	3360
lime, shale	3470
lime	3740
lime, shale	3854
Total Depth	

Tops:
Heebner 3506
Toronto ~~3545~~ 3531
Lansing ~~3789~~ 3545
Arbuckle ~~3852~~ **3789** → **B.K.C.**