

KANSAS

WELL COMPLETION REPORT AND
DRILLER'S LOGAPI No. 15 — 065 — 21,290
CountyS. 3 T. 10S R. 21 ^E
_W

Loc. NW SE SW

County Graham

Operator

John B. Collins

Address 1007 Cody - Suite A, Hays, Kansas 67601


Well No. #1 Lease Name Miller

Footage Location 990 feet from (N) (S) line 990 feet from (E) (W) line

Principal Contractor Dreiling Oil, Inc. Geologist Lawrence F. Gray

Spud Date 8-6-80 Date Completed 8-11-80 Total Depth 3875' P.B.T.D.

Directional Deviation Oil and/or Gas Purchaser

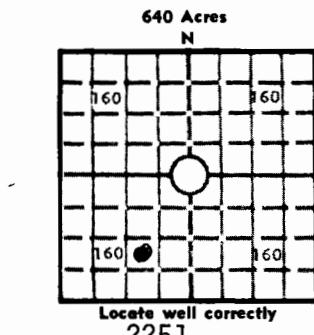

DF 2253 KB 2256

CASING RECORD

Report of all strings set — surface, intermediate, production, etc.

Purpose of string	Size hole drilled	Size casing set (in O.D.)	Weight lbs/ft.	Setting depth	Type cement	Sacks	Type and percent additives
Surface Pipe	12 $\frac{1}{4}$ "	8 5/8"		248'	Common	160	301# Cal. Cl. 225# Amon. Cl.
Production	7 7/8"	5 $\frac{1}{2}$ "		3873'	common	125	8% salt 4% gilsonite
							.1 of 1% GDL

LINER RECORD

PERFORATION RECORD

Top, ft.	Bottom, ft.	Sacks cement	Shots per ft.	Size & type	Depth interval

TUBING RECORD

Size	Setting depth	Packer set at		

ACID, FRACTURE, SHOT, CEMENT SQUEEZE RECORD

Amount and kind of material used	Depth interval treated

INITIAL PRODUCTION

Date of first production		Producing method (flowing, pumping, gas lift, etc.)				
RATE OF PRODUCTION PER 24 HOURS	Oil bbls.	Gas MCF	Water bbls.	Gas-oil ratio	CFPB	
Disposition of gas (vented, used on lease or sold)					Producing interval(s)	

INSTRUCTIONS: As provided in KCC Rule 82-2-125, within 90 days after completion of a well, one completed copy of this Drillers Log shall be transmitted to the State Geological Survey of Kansas, 4150 Monroe Street, Wichita, Kansas 67209. Copies of this form are available from the Conservation Division, State Corporation Commission, 245 No. Water, Wichita, Kansas 67202. Phone AC 316-522-2206. If confidential custody is desired, please note Rule 82-2-125. Drillers Logs will be on open file in the Oil and Gas Division, State Geological Survey of Kansas, Lawrence, Kansas 66044.

Operator

John B. Collins

DESIGNATE TYPE OF COMP.: OIL, GAS,
DRY HOLE, SWDW, ETC.:
Oil

Well No.	Lease Name
#1	Miller
S 3 T 10S R 21 E W	

WELL LOG

Show all important zones of porosity and contents thereof; cored intervals, and all drill-stem tests, including depth interval tested, cushion used, time tool open, flowing and shut-in pressures, and recoveries.

SHOW GEOLOGICAL MARKERS, LOGS RUN,
OR OTHER DESCRIPTIVE INFORMATION.

FORMATION DESCRIPTION, CONTENTS, ETC.	TOP	BOTTOM	NAME	DEPTH
Clay & Sand	0'	100'		
Sand & Water Gravel	100'	160'		
Shale	160'	1732'		
Anhydrite	1732'	1775'		
Shale	1775'	2436'		
Lime & Shale	2436'	3187'		
Lime	3187'	3875'		
	3875'	T.D.		

USE ADDITIONAL SHEETS, IF NECESSARY, TO COMPLETE WELL RECORD.

Date Received	John B. Collins
	Signature
	Operator
	Title
	9-12-80
	Date

50821

DREILING OIL, INC.

Victoria, Kansas 67671

3-10-21 W
C NE SW

WELL LOG

Company	J.B. Collins 1007 Cody - Suite A Hays, KS 67601	Sec. 3 C	Twp. 10 NW SE SW	Rng. 21
Farm	Miller	No. 1		
Total Depth	3,875'		County	Graham
Comm.	8-6-80	Comp. 8-11-80	Elevation:	2256 K. B.
Contractor	Dreiling Oil, Inc. Rt. #1 Victoria, KS 67671			2253 D. F.
				2251 G. R.

Casing Record	Cement Record	Production:
248' - 8 5/8"	160 sacks cement	
3,873' - 5 1/2"	cemented w/125 sacks	
	common	

Figures Indicate Bottom of Formations

0'	100'	Clay & Sand
100'	160'	Sand & Water gravel
160'	1732'	Shale
1732'	1775'	Anhydrite
1775'	2436'	Shale
2436'	3187'	Lime & Shale
3187'	3875'	Lime
3875'	T.D.	


STATE OF KANSAS)
)ss
COUNTY OF ELLIS)

I, Joseph A. Hess, Secretary Treasurer of Dreiling Oil, Inc., upon oath states that the above and foregoing is a true and correct copy from the Daily Drilling Report from the Miller #1.



Joseph A. Hess

Subscribed and sworn to before me this 18th day of August, 1980.

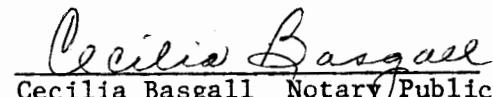
Cecilia Basgall Notary Public

CECILIA BASGALL
NOTARY PUBLIC
Ellis County, Kansas

My appointment expires: November 17, 1980.