


15-065-00206

KANSAS WELL LOG BUREAU---KANSAS GEOLOGICAL SOCIETY
508 EAST MURDOCK - WICHITA, KANSAS

COMPANY BARNETT DRILG., INC. et al
FARM McClellan NO. 1

SEC. 7 T. 10 R. 21W
LOC. NW NW NW

TOTAL DEPTH 3957
COMM. 12-11-50 COMP. 12-27-50
SHOT OR TREATED
CONTRACTOR
ISSUED 6-16-51

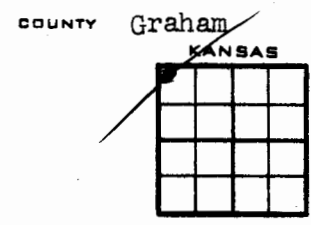

CASING
8 5/8" 164' cem. w/152 sx

ELEVATION 2322 RB (and)
2320
PRODUCTION Dry

FIGURES INDICATE BOTTOM OF FORMATIONS

surface clay	20
sand	30
shale & shells	60
sand	70
shale & shells	127
sand	154
shale & shells	164
shale	375
shale & shells	1305
sand	1540
shale & shells	1800
anhydrite	1840
shale & shells	2085
shale	2165
shale & lime	2485
lime	2610
lime & shale	3260
lime	3310
lime & shale	3365
lime	3862
lime & shale	3930
lime	3957
Total Depth	
Scout Tops:	
Anhydrite	1805
Heebner	3516
Kansas City	3556
Arbuckle	3927