


SECTION 22 TOWNSHIP 10S RANGE 15W

WELL NO. #1 Koehling

COMPANY Jones, Shelburne & Farmer

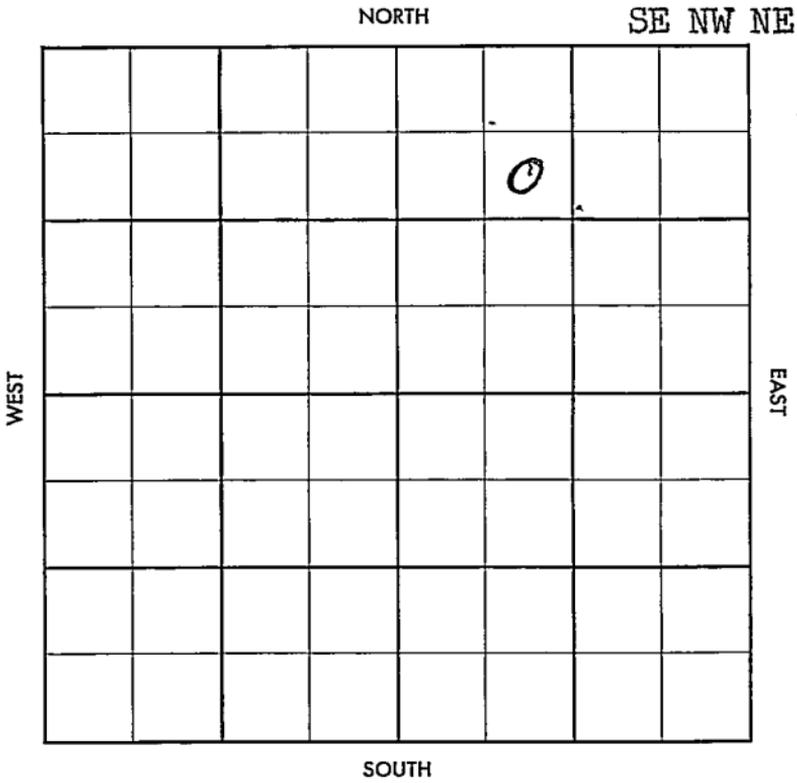



County Osborne Elev. 1838  
 Sec. 22 Twp. 10 Rge. 15W  
 Company Jones, Shelburne & Farmer  
 FarmName Koehling No. 1

TOPS	DEPTH	LOG	DATUM
Anh.	994		
Tp.	2702	2702	
H.	2942	2949	
Tr.	2969	2970	
Dg.			
Bl.			
L.	2995	2996	
K.C.			
B.K.C.		3266	
Ce.			
C.	91	3264	
M.	91A	3281	
M.			
K.			
Mz.			
Me.			
V.			
S.	56	346-	
S.			
A.			
R.			
Pe.			
G.			
T.D.	3418		

Loc. in Sec. 1  
SE NW NE  
 Geol. \_\_\_\_\_  
 Contr. \_\_\_\_\_  
 Co. Tools \_\_\_\_\_  
 Pool \_\_\_\_\_

COMPLETE

OCT 16 57

Date Comm.

Location SEC 22 T10 R15W 8-9-57 85/8  
312/140 DST 2730-66 1hr  
30' Md +550 200/20" DST  
2997-3040 30" rec 25' Md  
+550 580/20" DST 3040-65  
1hr 30' oil sptd Md 380/20"  
DST 3061-88 1hr 240' Ho 4' 6CM  
+730' & Light 9559 oil BMT  
900 DST 3090-3110 1hr 900'

SW BHP 860/30"  $\phi$  3238  
 AUG 21 57 DST 3350-70 60" RI 5#00GCM  
 F 0-100 BHP 560/30 5/2 3412/100SX  
 WUC + AUG 28 57 SEP 1 57 CO 16/  
 3366-70 +st 1 BOPH no/w  
 FRAC 4 x 4  $\phi$  7 BOPH +10%  
 WTR PB 3300 16/3082-86  
 $\phi$  11 BOPH no/w 12 SEP 11 57  
 $\phi$  35 B fld 90% WTR  
 SQD Perf WOC SEP 18 57  
 CO 3300 ~~perf~~ 9/3082-85  
 FU 340' oil 60' WTR 12 hrs  
 A  $\phi$  est 16 B Fld 50% WTR  
 Ph notime POP SEP 25 57 OCT 2 57  
 OCT 9 57 OCT 16 57 P 40 BOPH +40% W

L59 3082-85