


Osborne

KANSAS

SECTION 22 TOWNSHIP 10S RANGE 15W

WELL NO. #1 Bessie

COMPANY Icer Addis

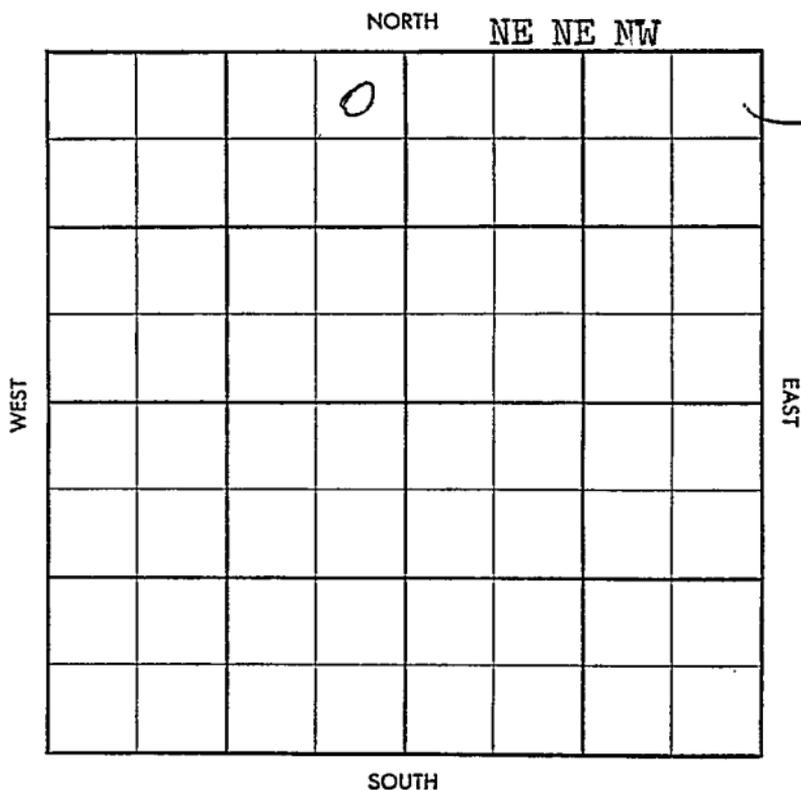



~~Top~~ ~~Foot~~  
~~Geology~~ ~~Facet~~

S-513-B

County Osborne Elev. 1833 RB 1830 D/F  
 Sec. 22 Twp. 10 Rge. 15W  
 Company Icer Addis  
 Farm Name Bessie No. 1

TOPS	DEPTH	LOG	DATUM
Anh.	<u>1018</u>		
Tp.	<u>2723</u>		
H.	<u>2967</u>		
Tr.	<u>2988</u>		
Dg.			
B.L.			
L.			
K.C.	<u>3011</u>		
B.K.C.			
Ce.			
<u>s. sdy c</u>	<u>3385</u>		
M.			
M.			
K.			
Mz.			
Mq.			
V.			
S.			
S.			
A.			
R.			
Pf.			
G.			
T.D.	<u>3398</u>		

Loc. in Sec. \_\_\_\_\_  
NE NE NW  
 \_\_\_\_\_  
 \_\_\_\_\_  
 Geol. \_\_\_\_\_  
 Contr. \_\_\_\_\_  
Triangle  
 \_\_\_\_\_  
 Pool \_\_\_\_\_  
Rugles



Date Comm. 4-21-58  
 Location 38 8" 213/140 3025  
MAY 7 58 DST 3386-94 1 1/2 65' MW  
BHP 660/20 no log

D6A

Co.  
 Lsc.  
 No.  
 Sec.  
 T.  
 R.