


Section 22 Township 10 Range 15W

Well No. #2 Koelling

Company Amerada

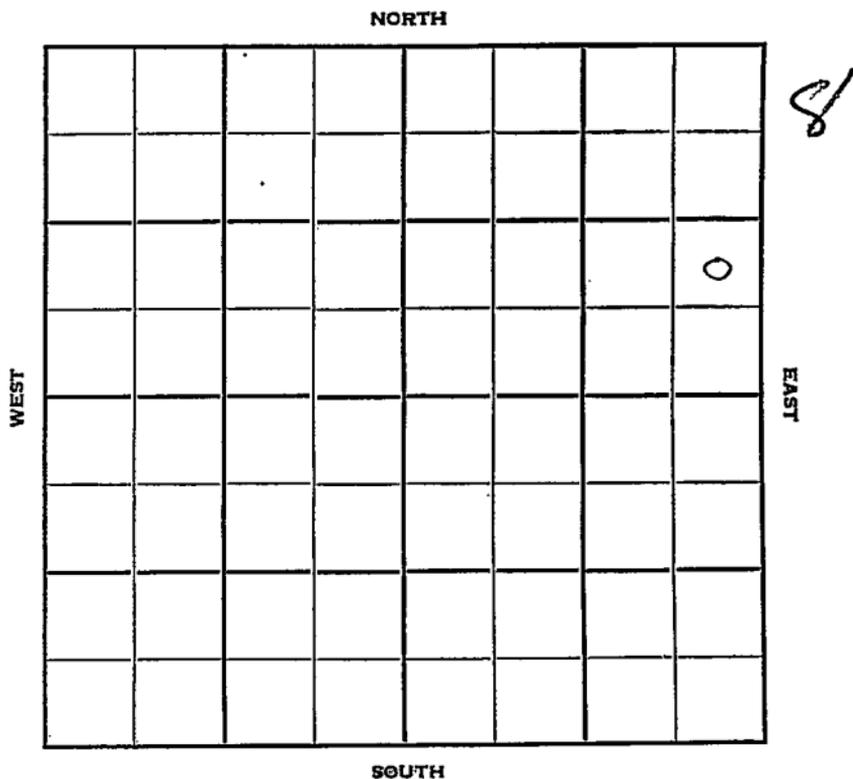

Sec. 22 Twp. 10 R. 15W

Well No. #2 Koelling Farm

Amerada Company

Contractor


Ft. from N. Line

990 Ft. from S. Line

330 Ft. from E. Line

Ft. from W. Line

NE SE NE

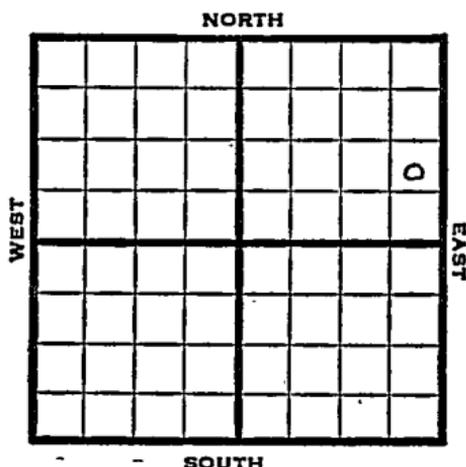

1952 Elev. 1835' REPORT

3/5 Location

3/12 8" @ 200'
Drilling 2684'

3/18 Anhy 985- Heeb. 2944
Br Li 2966 Lans. 2993
S.O. 3024-28 & 3037-39
DST 2998-3050 2 hr. 150' SO&GCM
1040' mud cut oil
DST 3050-92 2 hrs. 510' mud cut oil
250' wtr 0# Cong. 3356
DST 3356-91 2 hrs. 870' wtr cut mud
715' oil 355' wtr 890# G. 28
TD 3391 Schl 5" @ 3390'
WOC

3/25 Drlg. plug
4/1 24/ 3254-60 B 6 gal oil & 1/4 gal
wph 20/3365-70 B 22 gal oph
multi-frac S/ 233 BF, 8 hrs. 32%
wtr. 9% BS

4/9 NR

4/23 Spud 3-5-52
Oil Well TD 3391 8" @ 200'
Anhy 985 Heeb. 2944 Br Lm 2966
Lans. 2993' SO 3024-28 3037-39
DST 2998-3050 open 2 hr. rec. 150'
so & gcm 1040' mco

OVER

1952

4/23 DST 3050-92 open 2 hr. rec. 510' mco
250' wtr.-
Cong. 3356'
DST 3356-91 open 2 hr. rec. 870' wcm
715' oil 355' wtr. TD 3391
5" @ 3390' -24/ 3254-60 $\frac{1}{2}$ gmph
20/ 3360-65 B/ 6 go $\frac{1}{4}$ gwph
20/ 3365-70 B/ 22 goph multfrac
S/ 233 bf 8 hr. 32% wtr.
P/ 149 B0 37 bw 17 hr.
Comp. 386 bopd

COMPLETED

