


Map No. KANSAS Sec. 22 Twp. 10 R. 18WWell No. 1-1 Fisher Farm Lario Oil & Gas Company

NORTH

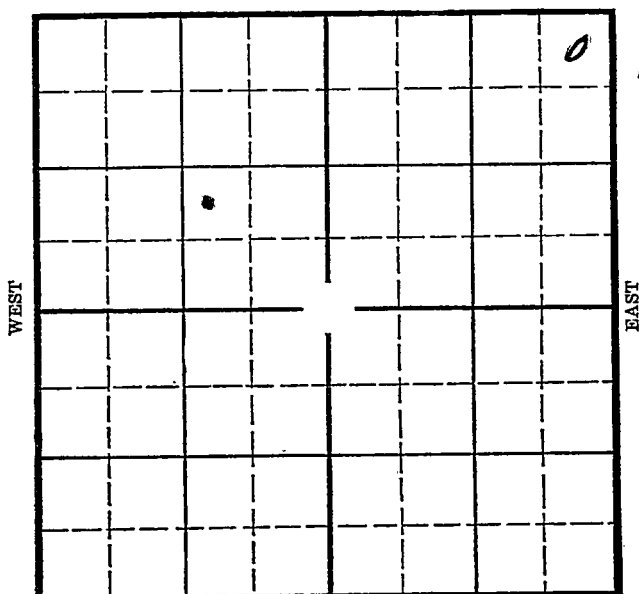

SOUTH

Location _____

Drilling Remarks _____

Rig Up _____

Drilling Remarks _____

RECORD

Cased _____ in. _____ ft.

Sand _____

Gas _____

Oil _____

Total Depth _____

PRODUCTION

1st 24 hrs. Nat. _____

1st 24 hrs. after shot _____

Gas _____ cu. ft. _____

Dry Hole _____

Abandoned _____

KANSAS

Map No. _____ Sec. 22 Twp. 10 R. 18^W

Well No. 1- Fisher Farm _____

Lario Oil & Gas Company

NORTH

330

Ft. from N. Line

Ft. from S. Line

330

Ft. from E. Line

Ft. from W. Line

Elev. 2148

WEST

EAST

SOUTH

Date

REPORT

7/17 Moving
8/8 Dlg 245
8/15 15 1/2 665
750 Lowering pipe
8/22 Dlg 945 12 1/2 925
8/29 " 1290 12 1/2 1270
9/6 " 1655
10/3 " 3117
10/10 " 3390 8" 2973
10/24 Lib 3774
TD 3781

D. & H.

ABANDONED

KANSAS

Map No. 64 Sec. 22 Twp. 10 R. 18WWell No. 1 - FisherLario oil & Gas Company

Contractor

R.S. REPORTS

SECTION PLAT

330 Ft. from N. Line

Ft. from S. Line

330 Ft. from E. Line

Ft. from W. Line

			0

Location

Rig up

Drilling and Remarks:

Moving

RECORD

Cased.....in.,ft.

Sand.....

Gas.....

Oil.....

Total Depth.....

PRODUCTION

1st 24 hrs. Nat.....

1st 24 hrs. after shot.....

Gas.....Cu. Ft.

Dry Hole.....

Abandoned.....

Date

W. L. TANTON

7-17-20 192

Scout

KANSAS

Map No. 64 Sec. 22 Twp. 10 R. 18WWell No. 1-FisherLario Oil & Gas Company

Contractor

ABANDONED

SECTION PLAT

330 Ft. from N. Line

.....Ft. from S. Line

330 Ft. from E. Line

.....Ft. from W. Line

			0

Location.....

Rig up.....

Drilling and Remarks:

107 FF

RECORD

Cased.....in.....ft.

Sand Oil 3774

Gas.....

Oil.....

Total Depth 3781

PRODUCTION

1st 24 hrs. Nat.....

1st 24 hrs. after shot.....

Gas.....Cu. Ft.

Dry Hole.....

Abandoned.....

Date

10-24-35 192

J. J. MANNING

Scout