


DX 78-1

Section 22 Township 10 Range 20W

Well No. 2 Rogers "A"

Company Derby Oil

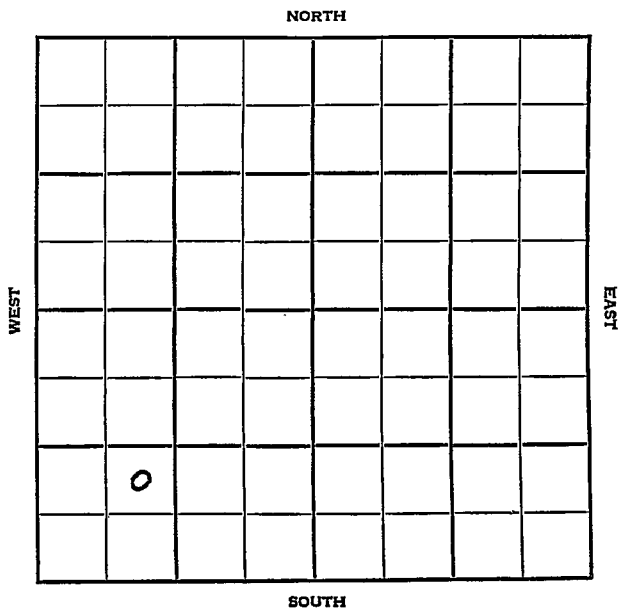

SEC.	TWP.	R.
22	10	20W

WELL NO. **2 Rogers "A"** FARM

COMPANY **Derby Oil**

CONTRACTOR


S. Marcotte Pool

_____ Ft. from N. Line

990 _____ Ft. from S. Line

_____ Ft. from E. Line

990 _____ Ft. from W. Line

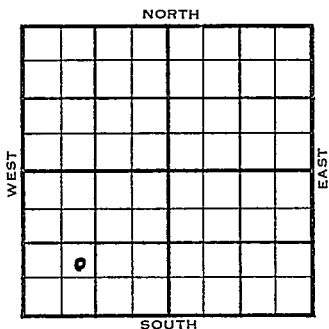

NE SW SW

	ELEVATION	REPORT
1954	2113'	

6/123

8" @ 202
Drlg. 2600

6/30

Heeb 3354'; Tor 3374'; Lans 3391';
B KC 3610'; Cong 3640'; Simp 3668';
Arb. 3685'
DST 3686-91, 1 hr., 240' gas, 180'
oil, 780#
RTD 3691'
5" @ 3687'

7/28

Oil well TD 3691 8" @ 202
Heeb 3354' Tor. 3374' Lans 3391'
B KC 3610' Cong. 3640' Simp 3668'
Arb. 3685'
DST 3686-91 open 1 hr rec 240' gas,
180' oil 780# TD 3691 5" @ 3687
C₀ to 3691 S/1½ BOPH 5 hr. 500 A
S/1½ BOPH 5 hr. 2% wtr. 1000 A
S/2 BOPH 1% wtr. Perf/3688-90
C₀ to 2692 S/4 BO 1 hr. S/3 BO
2nd hr. 1500 A S/6 BFPH 4 hr.
1% wtr. P/96 BO 2½ hr.
Comp. 1149 BOPD

COMPLETED

