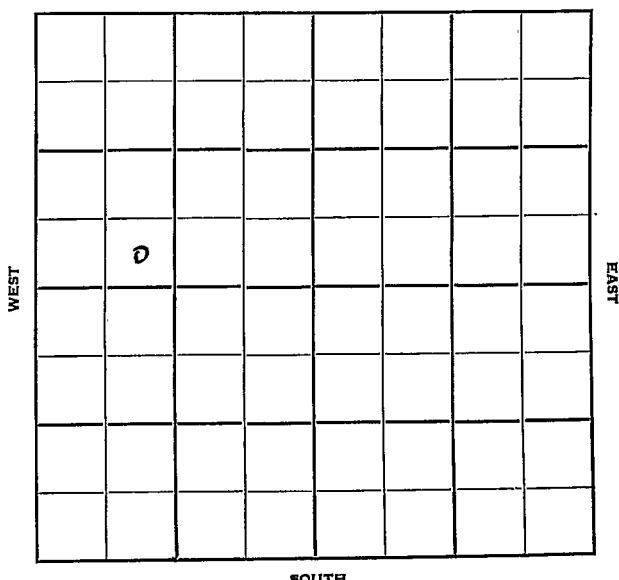


Section 22 Township 10 Range 20WWell No. 4 SaylesCompany Champlin Ref.Marcotte
NORTH

KANSAS

Rooks

Sec. 22 Twp. 10 R. 20W

Well No. #1 Sayles Farm

Champlin Ref. Company

Marcotte Pool

 Ft. from N. Line


330'

 Ft. from S. Line

 Ft. from E. Line

990'

 Ft. from W. Line

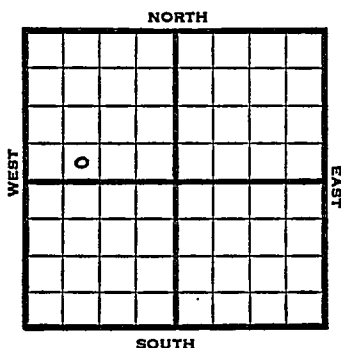

SE SW NW

1949 Elev 2111' REPORT

4/27 8" @ 166'
Anhy 1591'
Drlg. 2750'
5/4 Drlg 3819'
5/10 Drlg 3850'
5/18 TD 3850'
Lans/ 3403'
Cong 3730'
Arb. 3821'
Aband.

ABANDONED

Kansas

Marcotte Pool

Map No. _____ Sec. 22 Twp. 10 R. 20WWell No. 4 Sayles

Champlin Ref. _____ Company _____

FIRST REPORT

Contractor _____


SE SW NW

SECTION PLAT

_____ Ft. from N. Line

330 Ft. from S. Line

_____ Ft. from E. Line

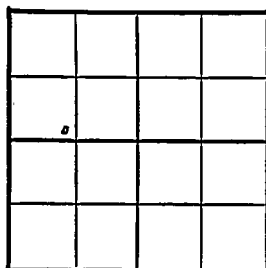990 Ft. from W. Line

Rooks County

Location _____

Rig up _____

Drilling and Remarks:

8" @ 166

Anhy 1591

drlg. 2750

RECORD

Cased _____ in., _____ ft.

Sand _____

Gas _____

Oil _____

Total Depth _____

PRODUCTION

1st 24 hrs. Nat. _____

1st 24 hrs. after shot _____

Gas _____ Cu. Ft.

Dry Hole _____

Abandoned _____

Date

APR 27 1949

19

S. J. LEWIS

Scout

Kansas


Map No. K65 Sec. 22 Twp. 10 R. 20WWell No. 4 Sayles

Champlin Ref. _____ Company _____

ABANDONED

Contractor _____

SE SW NW

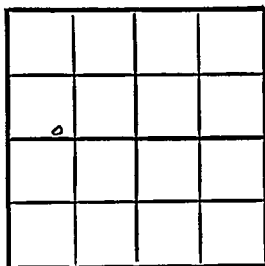E1211
SECTION PLAT

_____ Ft. from N. Line

330 Ft. from S. Line

_____ Ft. from E. Line

990 Ft. from W. Line

Rooks County

Location _____

Rig up _____

Drilling and Remarks:

Lane 3403
Cony 3230
Per 3321

RECORD

Cased _____ in., _____ ft.

Sand _____

Gas _____

Oil _____

Total Depth 3250**PRODUCTION**

1st 24 hrs. Nat. _____

1st 24 hrs. after shot _____

Gas _____ Cu. Ft.

Dry Hole _____

Abandoned _____

Date

MAY 18 1949

19

S. J. LEWIS

Scout