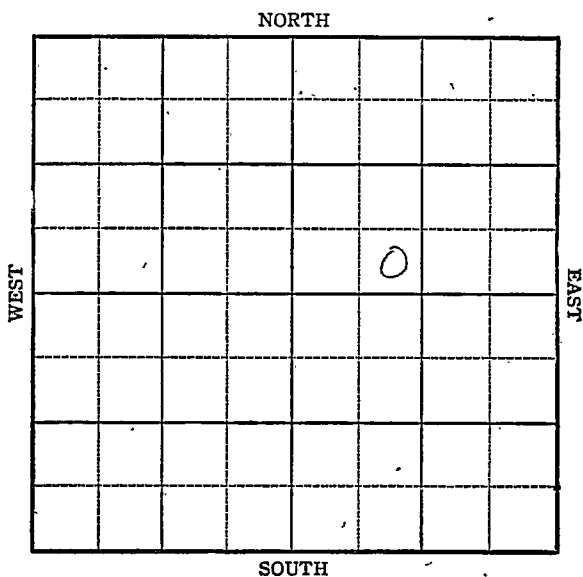


KANSAS

Rooks County

Section 22 Township 10 Range 20WWell No. #2 SutorCompany Champlin Ref.

KANSAS

Rooks County

Sec. 22 Twp. 10 R. 20W

Well No. #2 Sutor Farm

Champlin Ref. Company


Marcotte

 Ft. from N. Line

330 Ft. from S. Line

 Ft. from E. Line

990 Ft. from W. Line

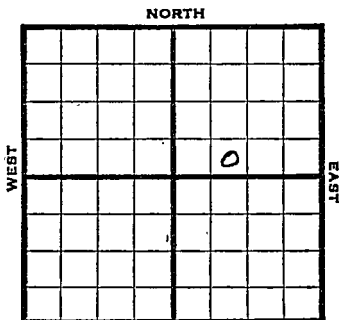

SE SW NE Elev. 2185 SOUTH

1944

R E P O R T

11/8 8" @ 160'
Anhy 1657
Drlg. 1702'

11/16 Drlg. 3010'
11/24 " 3835'

11/29 Lans 3457
Cong 3718
Simp 3803
Arb. 3818
TD 3835'

ABANDONED

Pool Name MarcotteMap No. 65 Sec. 22 Twp. 10 R. 20WWell No. 2 Sutor

Champlin Ref.

Company

FIRST REPORT

Contractor

S E SW NE

SECTION PLAT

Ft. from N. Line

330 Ft. from S. Line

Ft. from E. Line

990 Ft. from W. Line

Rocks

Location

Rig up

Drilling and Remarks:

8" - 160

Anhy 1657

1702

RECORD

Cased _____ in., _____ ft.

Sand _____

Gas _____

Oil _____

Total Depth _____

PRODUCTION

1st 24 hrs. Nat. _____

1st 24 hrs. after shot _____

Gas _____ Cu. Ft.

Dry Hole _____

Abandoned _____

Date

NOV 8 1944 19

S. J. LEWIS Scout

Pool Name Mar cotteMap No. 65 Sec. 22 Twp. 10 R. 20WWell No. 2 Sut or

Champlin Ref. Company

ABANDONED Contractor

SE SW NE

SECTION PLAT

		0	

Ft. from N. Line

330 Ft. from S. Line

Ft. from E. Line

990 Ft. from W. Line

Rocks

Location

Rig up

Drilling and Remarks:

*Lane 3457**Cong 3718**Sand 3823**Gr 3878*

RECORD

Cased in, ft.

Sand

Gas

Oil

Total Depth *3825*

PRODUCTION

1st 24 hrs. Nat.

1st 24 hrs. after shot

Gas Cu. Ft.

Dry Hole

Abandoned

Date

NOV 29 1944 19

S. J. LEWIS Scout