


Section 22 Township 10 Range 21 W

Well No. # 1 Miller "B"

Company Jones, Shelborne & Farmer

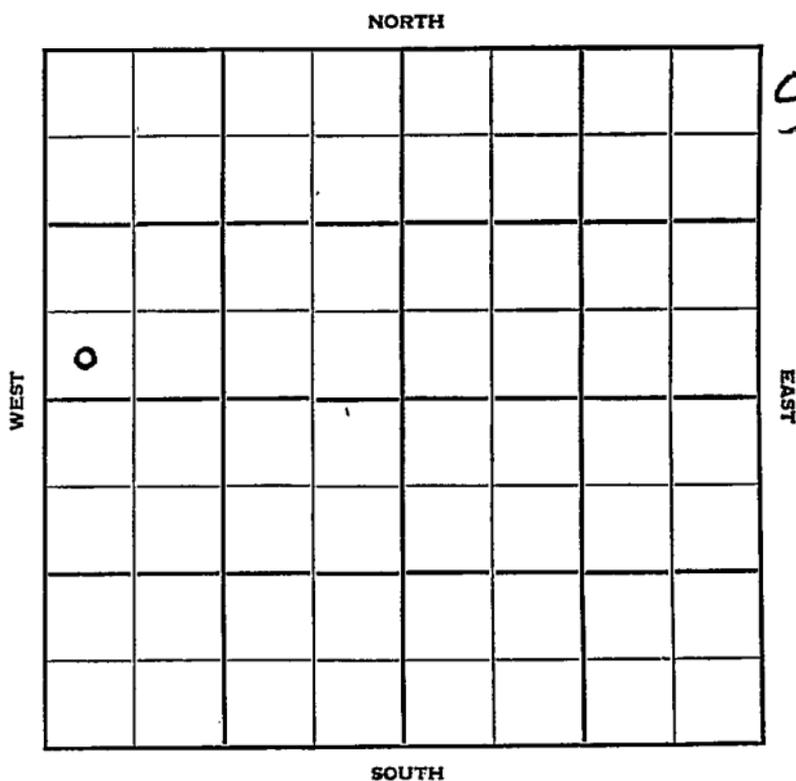

22

10

21W

Sec. _____ Twp. _____ R. _____

Well No. #1 Miller "B" Farm

Jones, Shelborne & Farmer Company


Contractor

Wildcat

Ft. from N. Line

NORTH

330' Ft. from S. Line

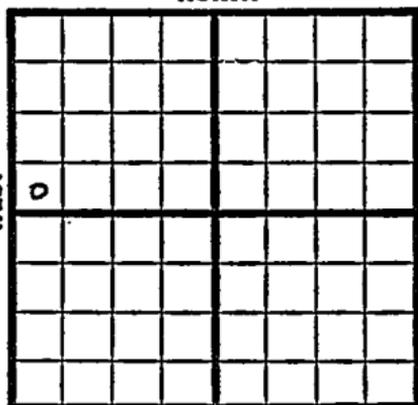

Ft. from E. Line

330' Ft. from W. Line

SW SW NW

SOUTH

1951 Elev. 2147' REPORT

3/7 RUR

3/21 Spud 3-6-51
 D&A TD 3850
 8" @ 155
 Anhy 1630 Heeb. 3408
 Lans. 3455' Cong. 3766
 Simp 3797 Arb. 3818
 TD 3850 D&A

ABANDONED

$$\begin{array}{r}
 3850 \\
 2147 \\
 \hline
 1703
 \end{array}$$


County Graham State Kansas

Sec. 22 (Blk.) 10 (Sur.) 21W Map No.

Operator Jones, Shelborne & Farmer

Well No. 1 Farm Miller "B"

Elev. _____ Location SW SW NW

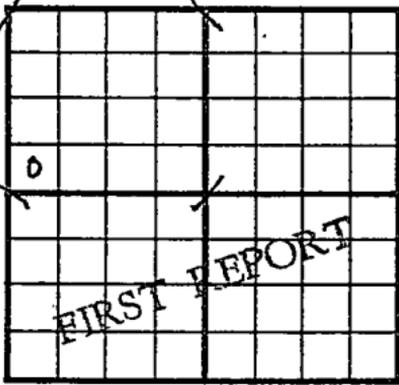

330 Ft. From S Line NW

330 Ft. From W Line Quarter

Ist. Report MAR 7 1951

Completion _____

Remarks Stano. & PhillipsDEM

Spudding Date _____

Drig. Data Wildcat

RUR

