FORM 51 25M 8-50 WESTERN Graham

KANSAS

Section 22 Township 10 Range 21W

Well No. #1 Svoboda

Company Jones, Shelburne & Farmer

NORTH

15

WEST

EAST

0

SOUTH

FORM 252-B
10M 10-50 PETROL

KANSAS

Graham

Sec. 22 Twp. 10 R. 21W

Well No. #1 Svoboda Farm

Jones, Shelburne & Farmer Company

Jones, Shelburne & Farmer Contractor

Wildcat

Ft. from N. Line

330 Ft. from S. Line

Ft. from E. Line

330 Ft. from W. Line

SW SW SE

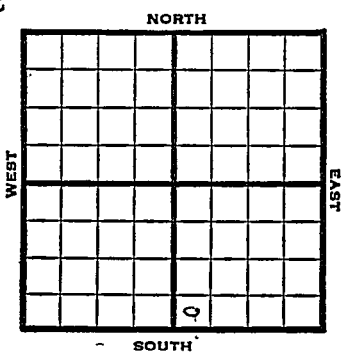

1952	Elev 2136' REPORT
3/26	MI
4/1	8" @ 160
	Anhy 1605
	Drlg. 2465'
4/9	Heeb. 3378 Tor. 3402
	Lans. 3412
	Drlg. 3650'
4/23	Spud 3-28-52
	D&A TD 3744 8" @ 160
	Anhy 1605 Heeb. 3378 Tor. 3402
	Lans. 3412 B KC 3644 Arb. 3742
	DST 3731-43 open 30 min. rec. 17'
	socm 5" @ 3743 TD 3743
	20/ 3730-35 500 A 20/ 3735-40
	1000 A S/ 6 go 6 gwph DD 3744
	S/ 6 go 6 gwph 2000 A S/ 35 bwph
	D&A

ABANDONED

FORM 275 FOR SALE BY KANSAS BLUE PRINT CO.

County Graham State Kansas

Sec. 22 (Blk. / Twp.) 10 (Sur. / Rge.) 21W Map No.

Operator Jones, Shelburne & Farmer

Well No. 1 Farm Svoboda

Elev. Location SW SW SE

330 Ft. From S Line SE

330 Ft. From W Line Quarter

1st. Report MAR 26 1952

Completion

Remarks

Jones, Shelburne&Farmer-Contr

Spudding Date

FIRST REPORT

Drlg. Data Wildcat

MT

J. G. McGEHEE

FORM 275 FOR SALE BY KANSAS BLUE PRINT CO.

County Graham State Kansas

Sec. 22 (Blk. / Twp.) 10 (Sur. / Rge.) 21W Map No.

Operator Jones, Shelburne & Farmer

Well No. 1 Farm Svoboda

Elev. 2136 Location SW SW SE

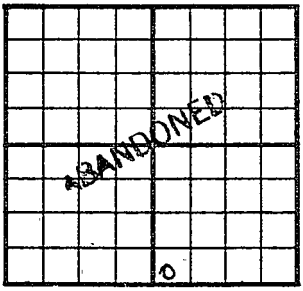

330 Ft. From S Line SE

330 Ft. From W Line Quarter

1st. Report

Completion APR 23 1952

Remarks Wildcat

J-S-F - Contr.

Spudding Date 3-28-52

Drlg. Data D & A TD 3744

8" @ 160 Anhy 1605 Heeb. 3378

Tor. 3402 Lans. 3412 B KC 3644

Arb. 3742 DST 3731-43 open 30 min.

Rec. 17' soom 5" @ 3743 TD 3743

20/ 3730-35 500 A 20/ 3735-40

1000 A S/ 6 go 6 gwph DD 3744

S/ 6 go 6 gwph 2000 A S/ 35 bwph

D & A

J. G. McGEHEE