
Graham

KANSAS

SECTION 22 TOWNSHIP 10S RANGE 22W

WELL NO. #1 Faulkner "L"

COMPANY Petroleum Inc.

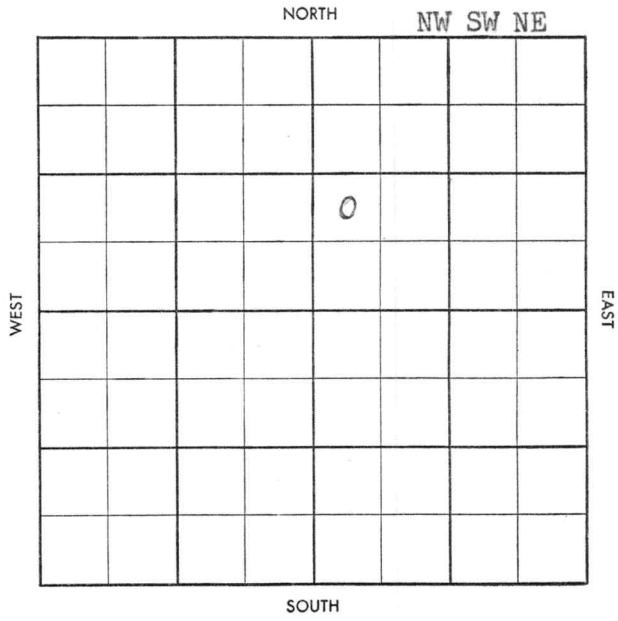

Twp. Pool

Co. Farm

S-513-B

County Graham Elev.

Sec. 22 Twp. 10 Rge. 22W

Company Petroleum Inc.

Farm Name Faulkner "L" No. 1

TOPS	DEPTH	LOG	DATUM
Anh.			
Tp.	1815		
H.			
Tr.			
Dg.			
B. L.			
L.			
K.C.			
B.K.C.			
Ce.			
C.			
M.			
M.			
K.			
Mz.			
Mq.			
V.			
S.			
S.			
A.			
R.			
Pf.			
G.			
T.D.			

Loc. in Sec. NW SW NE

Geol.

Contr. Garvey

Lse.

Pool Faul



No.

Date Comm. 7-11-58 Pan-Am - EO

Sec.

8" @ 255/175 drlg. 3020

T.

R.

Twp. X Pool X

Co. X Facet X

S-513-B

County Graham Elev. 2303 DF 2306 KB Co.

Sec. 22 Twp. 10 Rge. 22W

Company Petroleum Inc.

Farm Name Faulkner "L" No. 1

TOPS	DEPTH	LOG	DATUM
Anh.	1815		
Tp.	3505		
H.	3530		
Tr.	3550		
Dg.			
B.L.			
L.	3569		
K.C.			
B.K.C.			
Ce.			
C.			
M.			
M.			
K.			
Mz.			
Mq.			
V.			
S.			
S.			
A.			
R.			
Pf.			
G.			
T.D.	3942		

Loc. in Sec. NW SW NE

Geol.

Contr. Garvey

Lse.

Pool Faul

ABANDONED

JUL 30 '58

No.

Date Comm. 7-11-58 Pan-Am - FO

Sec.

8" @ 255/175 drlg. 3020 JUL 23 '58 DST

T.

3616-33 1hr 360 gip 180' HOCM 240' free oil 300 OCWCM 120' SW BHP 1140 DST 3638-3717 1hr 270' DM FP 80-260 BHP 1640 + 1200/20" DST 3722-3795 30" 25' M BHP 580 +½" 3940/150 WOCT JUL 30 '58 CO 3772

R.

12/3740-46 # 29 SOCMW ph NT

½ $ .87 BF scum oil NT

FORM 513-1 SUNRAY

Plug 3700 8/3621-23 100A
5/4BFPh 90°/oW 65°/oB
SQ CO 8/3607-11 $10 gw 50
~~25~~ pa pull A $15BWPh
Scum oil 700' oB

D6A

22-10-22W