

KANSAS


DX 78-1

Graham

Section 23 Township 10 Range 23W

Well No. #1 Conness

Company Francis Oil & Gas

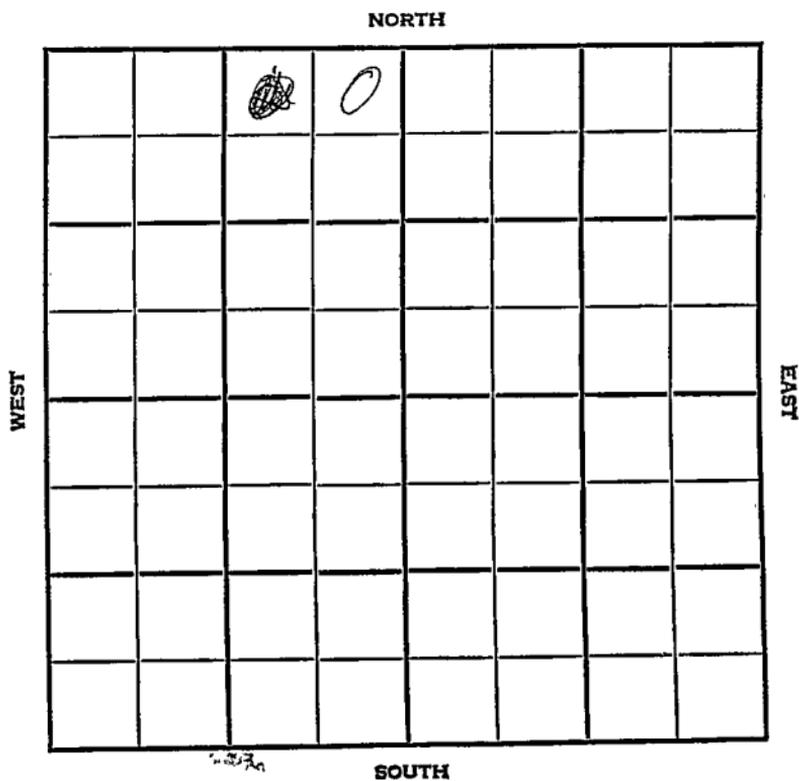

Graham

KANSAS

SEC. 23	TWP. 10	R. 23W
------------	------------	-----------


WELL NO. #1 Conness FARM

COMPANY Francis Oil & Gas

CONTRACTOR

WILDCAT

_____ FT. FROM N. LINE
 _____ FT. FROM S. LINE
 _____ FT. FROM E. LINE
 _____ FT. FROM W. LINE

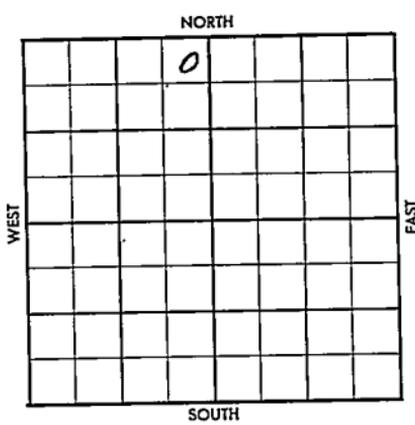

NE NE NW

1956	ELEVATION 2354 DF	REPORT
------	----------------------	--------

6-6
7-11

Location
 Comm. 6-27-56
 8 5/8" @ 197 w/150
 DST 3690-3743 op 45 min, rec. 65' MSW,
 BHP 1050/15".
 DST 3745-75 op 1 hr., rec. 125' MSW,
 BHP 950/15".
 DST 3818-60 op 45 min,, rec.10' mud,
 BHP 0/15".
 D & A
 Anh. 890'; H. 3629'; L. 3663';
 BKC 3896';
 Log tops:H. 3626'; Tr. 3648';L. 3661';
 BKC 3893';
 TD 3925';

ABANDONED

County Graham Elev. _____
 Sec. 23 Twp. 10 Rge. 23W
 Company Francis Oil & Gas
 Farm Name Conness No. 1

TOPS	DEPTH	LOG	DATUM
Anh.			
Tr.			
H.			
Tr.			
Dg.			
Bl.			
L.			
K.C.			
B.K.C.			
Ce.			
C.			
M.			
M.			
K.			
Mz.			
Ma.			
V.			
S.			
A.			
R.			
Pe.			
G.			
T.D.			

Loc. in Sec. NE NE NW

Geol. _____
 Contr. _____

Pool Wildcat

	0	
FIRST REPORT		
JUN 6 1956		

Date Comm. _____
 Location _____

JUN 1 1956

W.C.

Co.

Sec.

No.

Sec.

T.

R.

County Graham Elev. 2354 DF
 Sec. 23 Twp. 10 Rge. 23W
 Company Francis Oil Gas
 Farm Name Conness No. 1

TOPS	DEPTH	LOG	DATUM
Anh.	890		
TP.			
H.	3629	3626	
Tr.		3648	
Dg.			
Bl.			
L.	3663	3661	
K.C.			
B.K.C.	3896	3893	
Ce.			
C.			
M.			
M.			
K.			
Mz.			
Ma.			
V.			
S.			
S.			
A.			
R.			
PE.			
G.			
TD.	3925		

Loc. in Sec.

N 1/4 NW 23

Geol.

Contr.

Pool

Willcat

ABANDONED

JUL 1 1 1956

Date Comm.

Skell & Champ & Area DHP

Location

JUN 13 '56 JUN 20 '56 JUN 27 '56 JUL 3 '56

6-27-56 8 5/8 197/150

2875 JUL 11 '56 DST ~~3735~~-3690

-3743 or 45" rec 65' MSW BHP

1050/15" DST 3745-75 1 hr rec

125' MSW BHP 950/15" DST

3818-60 or 45" rec 10' Md

BHP 0/15"

DPA