

Graham

KANSAS


SECTION 23 TOWNSHIP 10S RANGE 23WWELL NO. #3 Conness "A"COMPANY Kaiser Francis *@ SW/4*

NORTH

~~NW NW SW~~

WEST

EAST

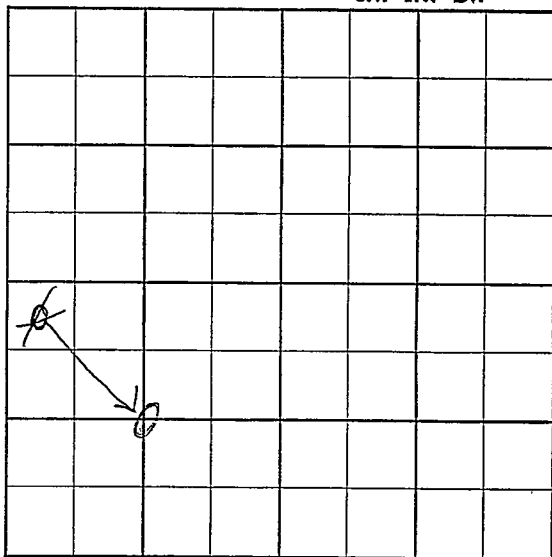

SOUTH

S-513-B

~~T. X~~ ~~X~~
~~Co. X~~ ~~Fast~~

County Graham Elev. _____
 Sec. 23 Twp. 10 Rge. 23W
 Company Kaiser Francis
 Farm Name Conness "A" No. 3

TOPS	DEPTH	LOG	DATUM
Anh.			
Tp.			
H.			
Tr.			
Dg.			
B.L.			
L.			
K.C.			
B.K.C.			
Ce.			
C.			
M.			
M.			
K.			
Mz.			
Mq.			
V.			
S.			
S.			
A.			
R.			
Pf.			
G.			
T.D.			

Loc. in Sec. _____


NW NW SW

Geol. _____

Contr. _____

M. B. Armer

Pool _____

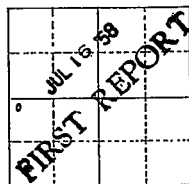Conness

Date Comm. _____

Location

~~Top~~ ~~Pool~~ ~~116~~
~~Fact~~ ~~No~~
~~CORRECTION~~

S-513-B

County Graham Elev. 2354 KB
 Sec. 23 Twp. 10 Rge. 23
 Company Kaiser Francis
 Farm Name Conness "A" No. 3

TOPS	DEPTH	LOG	DATUM
Anh.			
Tp.			
H.	<u>3618</u>		
Tr.	<u>3638</u>		
Dg.			
B.L.			
L.	<u>3653</u>		
K.C.			
B.K.C.	<u>3876</u>		
Ce.			
C.			
M.			
M.			
K.			
Mz.			
Mq.			
V.			
S.			
S.			
A.			
R.			
Pf.			
G.			
T.D.	<u>3880</u>		

Loc. in Sec. 23
25W/4

Geol. _____
 Contr. _____
J. T. Armer

Pool _____
Conness

ABANDONED

X
 SFP 3 '58

Date Comm. 8-23-58 8" 214/170
 Location JUL 23 '58 JUL 30 '58 AUG 6 '58 AUG 13 '58
AUG 20 '58 AUG 27 '58 6 2242 SFP 3 '58 1257

3728-47 2 hrs 360' W BHPO
DST 3818-62 1 hr 10' M BHPO

No log

D & A