

Ottawa

Section 23 Township 10 Range 1W

Well No. #1 Hapwood

Company W.C. Emrich

NORTH

|   |  |  |  |  |  |  |  |
|---|--|--|--|--|--|--|--|
|   |  |  |  |  |  |  |  |
|   |  |  |  |  |  |  |  |
| ○ |  |  |  |  |  |  |  |

SOUTH

WEST

EAST

13

Ottawa

Sec. 23 Twp. 10 R. 1W

Well No. #1 Hapwood Farm

W.C. Emrich Company

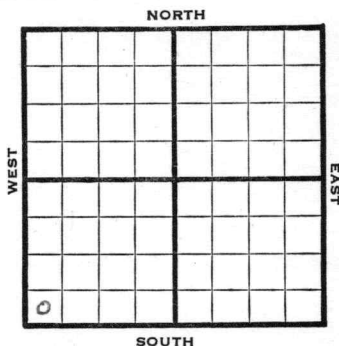
Wildcat

         Ft. from N. Line

330 Ft. from S. Line

         Ft. from E. Line

330 Ft. from W. Line



1944

R E P O R T

5/3 Cable rig.

5/10 "

5/17 "

5/24 "

5/31 "

6/7 "

6/15 "

6/21 "

6/28 "

7/12 "

7/19 "

7/26 "

8/2 "

8/9 "

8/16 " "

8/23 Spud 65' SD

8/30 " " "

9/8 " " "

9/13 " " "

9/21 " " "

9/28 " " "

10/4 " " "

10/11 " " "

10/18 " " "

10/25 " " "

11/2 " " "

11/8 " " "

OVER

1944

11/16 Spud 65' SD

11/24 " " "

11/29 TD 65'

ABANDONED

KANSAS

Pool Name WildcatMap No. 60 Sec. 23 Twp. 10 R. 1WWell No. 1 HapwoodW. C. Emrich

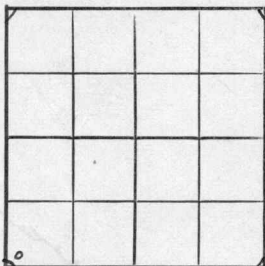
Company

## FIRST REPORT

Contractor

SW/C

## SECTION PLAT

       Ft. from N. Line330 Ft. from S. Line       Ft. from E. Line330 Ft. from W. LineOttawa CountyLocation                                 Rig up                                 

Drilling and Remarks:

Cable rig

## RECORD

Cased            in.,            ft.Sand                                 Gas                                 Oil                                 Total Depth                                 

## PRODUCTION

1st 24 hrs. Nat.                                 1st 24 hrs. after shot                                 Gas                                  Cu. Ft.Dry Hole                                 Abandoned                                 

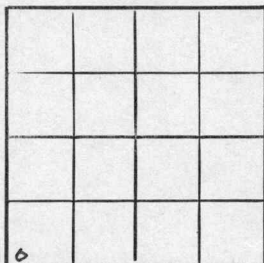
Date

MAY 3 1944 19S. J. LEWIS Scout

Pool Name WildcatMap No. 60 Sec. 23 Twp. 10 R. 1WWell No. 1 HapwoodW. C. Emrich CompanyABANDONED Contractor

SW/c

## SECTION PLAT

         Ft. from N. Line330 Ft. from S. Line         Ft. from E. Line330 Ft. from W. LineOttawaLocationRig upDrilling and Remarks:

## RECORD

Cased          in.,          ft.Sand         Gas         Oil         Total Depth 65

## PRODUCTION

1st 24 hrs. Nat.         1st 24 hrs. after shot         Gas          Cu. Ft.Dry Hole         Abandoned         

Date

NOV 29 194419S. J. LEWISScout