

Section 23 Township 10 Range KANSAS 5W

Well No. #1 Ruggles (B)

Company Anderson & Prichard

NORTH

	0						

WEST

EAST

SOUTH

12

Sec. 23 Twp. 10 R. 15 W

Well No. # 1 Ruggles (B) Farm

Anderson & Prichard Company

Contractor


330 Ft. from N. Line

_____ Ft. from S. Line

_____ Ft. from E. Line

990 Ft. from W. Line

NE NW SW

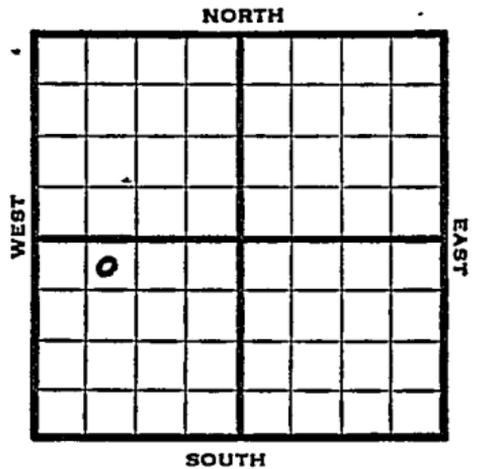

1952

Elev. 1864' REPORT

8/6 Spud 8-3-52
8" @ 214
Anhy 998'
Drlg. 1029'

8/13 Heeb. 2979` Tor. 3001
Lans. 3027 Cong. 3388'
DST 3388-93'

8/20 DST 3378-3404, 1 hr, 75' VSOCM &
traced water 770#
Arb. 3485' RTD 3505' 5" @ 3504
CO 3448' 36/3128-34 S/1 1/2 BWPB
for 5 hrs. 250 A S/25 BW 3 hrs.
To sq.

8/27 CO 3448 13,116-22 4 gals & 10
galwph 500 A S/23 BO & 205 BW
12 hrs. PB 3071 36/3056-62
S/26 1/2 BO & 193 BW 12 hrs.
sq off CO 3071 24/3056-60
S/5 galoph

9/3 500 A S/ 53 BO & 25 BW 17 hrs.

9/10 P/44 BO 18 hrs.

9/17 Spud 8-3-52 Oil Well TD 3505
8" @ 214' Anhy 998 Heeb. 2979
Tor. 3001 Lans. 3027
Cong. 3388

OVER

1952

9/17 DST 3378-3404 open 1 hr. rec. 75'
vsocm tr. wtr. 770# Arb. 3485'
TD 3505' 5" @ 3504 CO to 3448
36/ 3128-34 S/ $1\frac{1}{2}$ bwph 5 hr.
250 A S/ 25 BW 3 hr. CO 3448
Perf/ 3116-22 B/ 4 go 10 gwph
500 A S/ 23 B0 205 BW 12 hr.
PB 3071 36/ 3056-62 S/ $26\frac{1}{2}$ bo
193 bw 12 hr. CO 3071'
24/ 3056-60 S/ 5 goph 500 A
S/ 53 B0 25 BW 17 hr. P/ 44
bo 18 hr.
Comp. 79 bopd


County Osborne State Kansas

Sec. 23 (Blk. Twp.) 10 (Sur. Rge.) 15W Map No.

Operator Anderson & Pritchard

Well No. 1 Farm Ruggles (B)

Elev. _____ Location NE NW SW

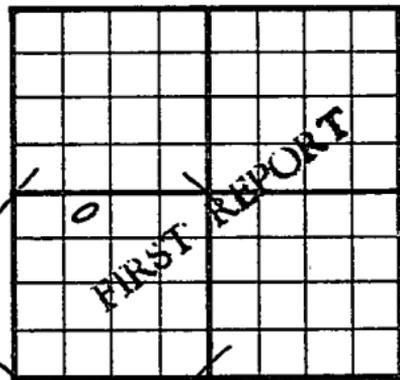

330 Ft. From N Line SW

990 Ft. From W Line Quarter

Ist. Report AUG 6 1952

Completion _____


Remarks _____

Spudding Date 8-3-52

Drlg. Data _____

8" @ 214 Anhy 998 Drlg. 1029

County Osborne State Kansas
 Sec. 23 (Blk. Twp.) 10 (Sur. Rge.) 15W Map No.
 Operator Anderson-Prichard
 Well No. 1 Farm Ruggles "B"
 Elev. 1864 Location NE NW SW

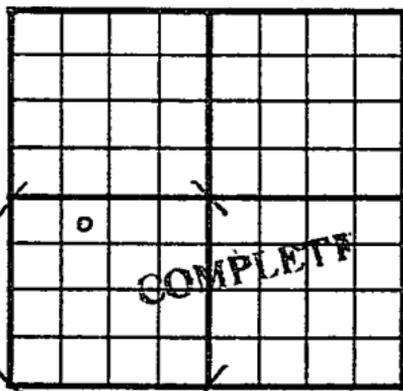

330 Ft. From N Line SW

990 Ft. From W Line Quarter

1st. Report

Completion SEP 17 1952

Remarks

Spudding Date 8-3-52

Drig. Data Oil well TD 3505

8" @ 214 Anhy 998 Heeb. 2979

Tor. 3001 Lans. 3027 Cong. 3388

DST 3378-3404 open 1 hr. Rec. 75' vsocm

tr. wtr. 770# Arb. 3485 TD 3505

5" @ 3504 CO to 3448 36/ 3128-34

S/ 1½ bwph 5 hr. 250 A S/ 25 bw 3 hr.

CO 3448 Perf/ 3116-22 4 go 10 gwph

500 A S/ 23 bo 205 bw 12 hr. PB 3071

36/ 3056-62 S/ 26½ bo 193 bw 12 hr.

CO 3071 24/ 3056-60 S/ 5 goph 500 A

S/ 53 bo 25 bw 17 hr. P/ 44 bo 18 hr.

Comp. 79 bopd

J. G. McGEHEE