

Section 23 Township 10 Range 15W

Well No. #2 Ruggles

Company Anderson & Prichard

NORTH

	0						

4

WEST

EAST

SOUTH

Osborne

KANSAS

Sec. 23 Twp. -10 R. 15W

Well No. #2 Ruggles Farm

Anderson & Prichard Company

Contractor

Ruggles


990 Ft. from N. Line

Ft. from S. Line

Ft. from E. Line

990 Ft. from W. Line

SE NW NW

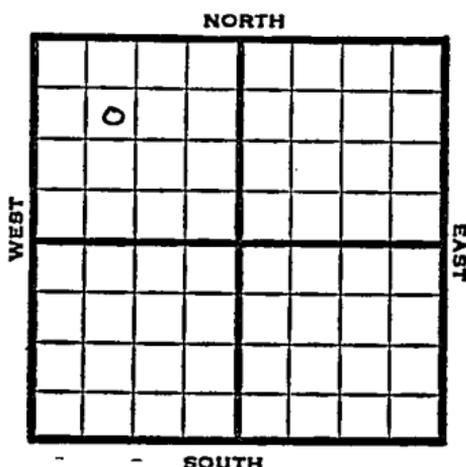

1952

Elev. 1888' REPORT

3/5 MI

3/12 8" @ 200
Drlg. 2750'

3/19 Anhy 1045 Heab. 2992
Gor 3014 Lans. 3042
DST 3000-3060 1 hr. No Rec.
DST 3058-82 1/4 hr. 90' HO&GCM
some free oil 1010# DST 3083-98
1 1/2 hr. 90' HOCM 510' oil
DST 3100-3136 1hr. 240' gas 275'
O&GCM 1100# DST 3140-45 1 1/2 hr.
1500' gas 150' oil 90' MCO 150'
HO&GCM 240' GCwtr 1090#
Cong. 3406
DST 3394-3424 1 hr. 1590' oil
210' OCM 880# Arb. 3501
Drlg. 3506'

3/25 RTD 3525 5" @ 3506

4/1 Perf 3404-10 dry Hydra

4/9 Test 10 gal wph sq. off 76/3416-30
BOPH & 6% wtr. 3 hrs. POP

4/23 NR

4/30 P/107 BO 7 1% wtr 11 hrs.

5/7 P/ 220 BO & 1% wtr. 22 hrs.

OVER

1952

5/14 Spud 3-5-52
Oil Well TD 3525
8" @ 200
Anhy 1045 Heeb. 2992
Tor. 3014 Lans. 3042
DST 3000-3060 opn 1 hr. no rec.
DST 3058-82 opn 15 min. Rec. 90'
ho & gcm some free oil
DST 3088-98 opn 1½ hr. Rec. 90'
hocm 510' oil
DST 3100-3136 opn 1 hr. Rec. 240' gas
275' o & gcm
DST 3140-45 opn 1½ hr. Rec. 1500' gas
150' oil 90' mco 150' ho & gcw
240' gcw Cong. 3406
DST 3394-3424 opn 1 hr. Rec. 1590'
oil 210' ocm Arb. 3501
TD 3525 5" @ 3506
Perf 3404-10 dry Hydra 10 gwph
76/3416-30 S/20 boph 6% wtr
P/107 bo 1% wtr 11 hr.
Comp. 311 bopd

COMPLETED

Dirig. Data

76/ 3416-30 S/ 20 boph 6% water

P/ 107 bo 1% water 11 hr.

Comp. 311 bopd

..... Misc.
..... Pierce Map
..... France Map
..... Tracings
..... Land Wall Map
..... Land Small Map
..... Scout Cards

[Handwritten signature]

NOV 23 1952