


Section 23 Township 10 Range 15W

Well No. #3 Ruggles

Company Anderson-Prichard

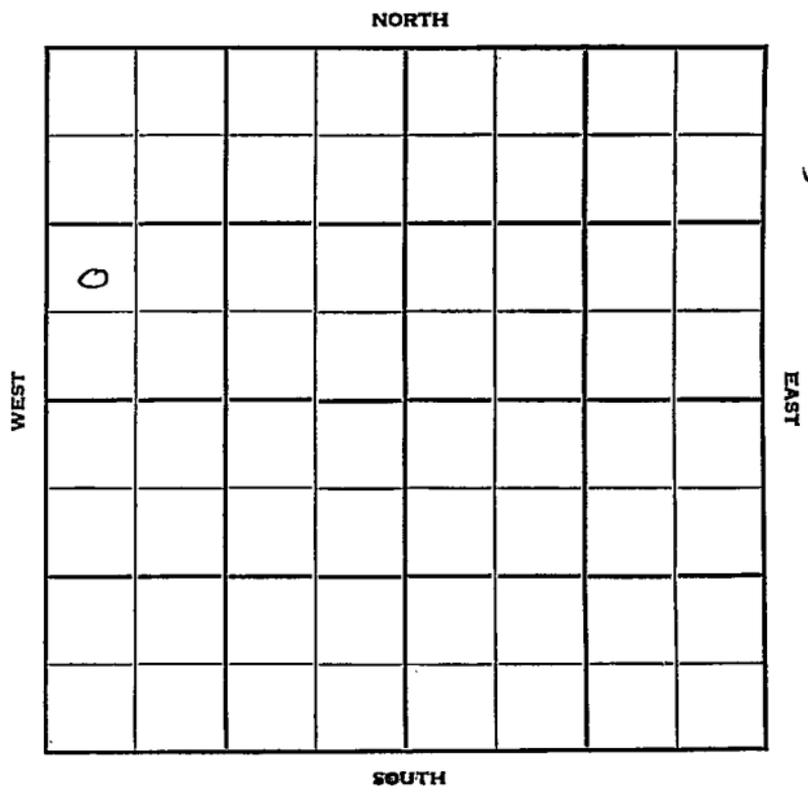

Osborne

KANSAS

Sec. 23 Twp. 10 R. 15W

Well No. #3 Ruggles Farm

Anderson-Prichard Company

Contractor

Ruggles


Ft. from N. Line

990 Ft. from S. Line

Ft. from E. Line

330 Ft. from W. Line

NW SW NW

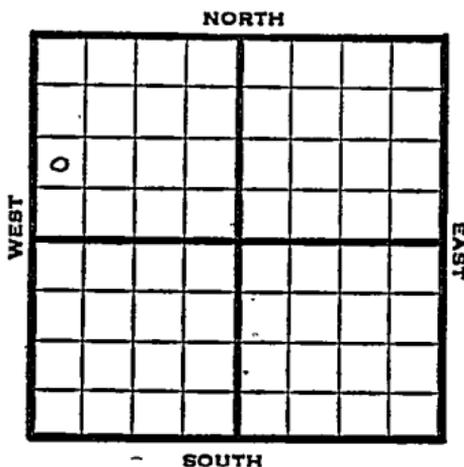

1952

Elev. 1870' REPORT

3/26

Location

4/1

RUR

4/9

8" @ 242 Anhy 1035 Heeb. 2975

Tor. 300 Lans. 3027

DST 3048-62, 1 1/2 hr. 600' gassy

oil 1050# FP 200#

DST 3066-78, 1 hr. 1440' gas

120' MCO 1070#

Drlg. 3155'

4/23

RTD 3458' 5" @ 3458'

Cong. 3391' Simp. 3443'

CO to 3424' Perf Testing

4/30

CO 3424 24/3398-3404 S/8 gal oil

& 5 gal WPH tub & rods to A

5/7

Hyd S/ 1 BO & 5% wtr ph S/ 1 1/2 BO &

1 1/2 Bwph S/ 9.6 BOPH & 5% wtr. for

24 hrs.

5/13

P/20 BO & 1% wtr for 24 hrs.

5/21

Spud 4-1-52

Oil Well TD 3458' 8" @ 242'

Anhy 1035 Heeb. 2975

Tor. 3000 Lans. 3027

DST 3048-62 open 1 1/2 hr. rec. 600'

gassy oil

DST 3066-78 open 1 hr. rec. 1440' gas

120' mco

OVER

1952.

5/21 DST-3218-28 open 1 hr. rec. 90' HO&GCM
DST-3238-55 open 1 hr. rec. 25' mud
Cong. 3391
DST 3399-3408 open 1 hr. rec. 128'
HOCM Simp. 3443' TD 3458
5" @ 3458' CO to 3424' 40/ 3396-3404
8/ 3400-3404 1 boph 24/ 3404-10
S/ 8 bo 5 hr. 12/ 3410-13 24 bo
40 bw 21 hr. 24/ 3413-19 9½ bo
32 bw 11 hr. CO to 3424
24/ 3398-3404 S/ 18 go 5 gwph
Hydro. S/ 1 bo 5% wtr. S/ 1½ bo
1½ bwph S/ 96 bo 5% wtr. 24 hr.
P/ 20 bo 1% wtr. 24 hr.
Comp. 41 bopd

COMPLETED

Drlg. Data

S/ 1 bo 5% water S/ $1\frac{1}{2}$ bo $1\frac{1}{2}$ bwph

S/ 96 bo 5% water 24 hr.

P/ 20 bo 1% water 24 hr.

Comp. 41 bopd

MAY 27 1952

| |
|----------------|
| Misc. |
| Pierce Map |
| France Map |
| Tracings |
| Land Wall Map |
| Land Small-Map |
| Scout Cards |

Handwritten initials: JNV