


Section 23 Township 10 Range 15W

Well No. #6 Ruggles

Company Anderson-Prichard

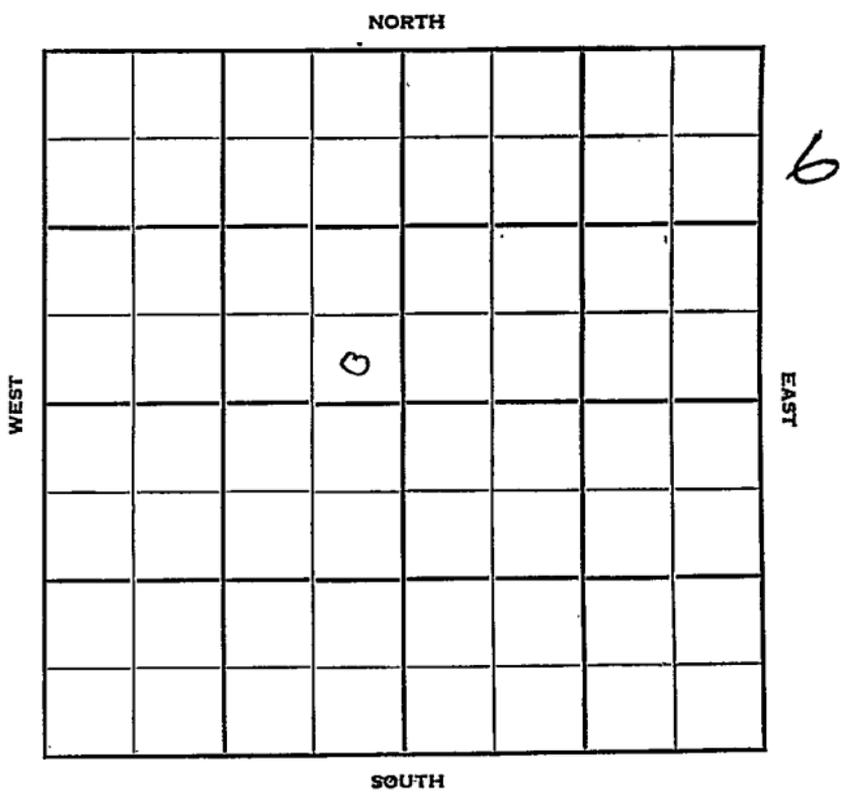

Sec. 23 Twp. 10 R. 15 W

Well No. # 6 Ruggles Farm

Anderson-Prichard Company

Peel Drlg. Contractor

Ruggles


..... Ft. from N. Line

330 Ft. from S. Line

330 Ft. from E. Line

..... Ft. from W. Line

SE SE NW

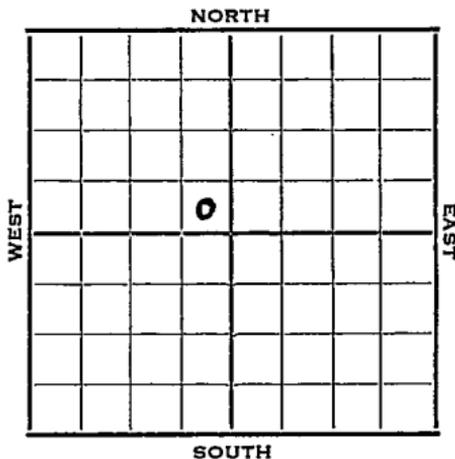

1952 Elev. 1849' REPORT

~~XXXXXX~~

- 6/11 Spud 6-4-52  
8" @ 252'  
Drlg. 2503'
- 6/18 Heeb 2965'  
DST 2972-3005, 1 hr, 140' gassy OCM  
100#  
Lans. 3013'  
DST 3034-50, 1 hr, 90' OCM 820#  
DST 3056-82, 1 hr, 75' HG & WCM  
100' WCM 950#  
DST 3170-3215, 1 hr, 215' wtr.  
Cong. 3374'  
DST 3366-90, 1 hr, 5' OCM  
RTD 3440 5" @ 3350 WOC
- 6/25 ( Cor. 5" @ 3390')
- 7/2 CO 3050 44/3042-50 5 gals & 5 galwph  
500 A No Help PB 3008  
16/2986-90 B/5½ galoph 500 A  
S/1½ BOPH 5% wtr tub & rods
- 7/9 P/50 BOPD & 1½ BW
- 7/17 NR

OVER

1952

7/23

Spud 6-4-52

Oil Well TD 3440 8" @ 252

Heeb. 2965

DST 2972-3005 opn 1 hr. Rec 140'

gocm 100# Lans. 3013

DST 3034-50 opn 1hr. Rec. 90' ocm

820# DST 3056-82 opn 1 hr. Rec.

75' hg& wcm 100' wcm 950#

DST 3170-3215 opn 1 hr. Rec. 215' wtr

540# Cong. 3374

DST 3366-90 opn 1 hr. Rec. 5' ocm

TD 3440 5" @ 3390 Tor. 2986

Simp 3429 CO to 3050 44/3042-50

5 go 5 gwph 500 A PB 3008

16/2986-90 B/2½ goph 500 A

S/1½ boph Comp. 51 bopd 3% wtr.


County Osborne State KANSAS

Sec. 23 (Blk. Twp.) 10 (Sur. Rge.) 15W Map No.

Operator Anderson\*Prichard

Well No. 6 Farm Ruggles

Elev. \_\_\_\_\_ Location SE SE NW

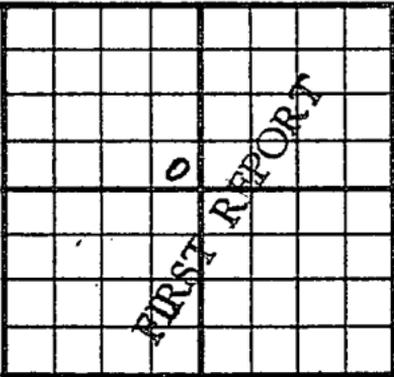

330 Ft. From S Line NW

350 Ft. From E Line Quarter

Ist. Report JUN 11 1952

Completion \_\_\_\_\_

Remarks \_\_\_\_\_

Peel Drlg. - Contr.


Spudding Date 6-4-52

Drlg. Data Ruggles Pool

8" @ 252 drlg. 2503

J. G. McGEHEE

County Osborne State Kansas  
 Sec. 23 (Blk. Twp.) 10 (Sur. Rge.) 15W Map No.  
 Operator Anderson-Prichard  
 Well No. 6 Farm Ruggles  
 Elev. 1849 Location SE SE NW

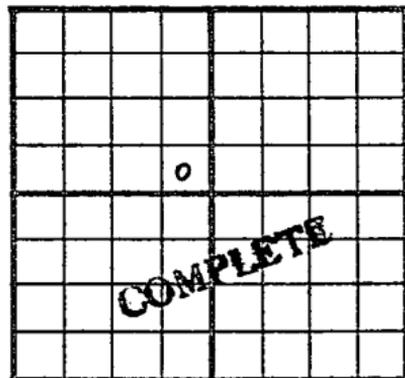

330 Ft. From S Line NW  
 330 Ft. From E Line Quarter  
 Ist. Report  
 Completion JUL 23 1952  
 Remarks Ruggles Pool  
 Peel Drlg. - Contr.  
 Spudding Date 6-4-52

Drlg. Data Oil well TD 3440  
 8" @ 252 Heeb. 2965 DST 2972-3005  
 open 1 hr. Rec. 140' goem 100#  
 Lans. 3013 DST 3034-50 open 1 hr.  
 Rec. 90' ocm 820# DST 3056-82  
 open 1 hr. Rec. 75' hg & wcm 100' wcm  
 950# DST 3170-3215 open 1 hr.  
 Rec. 215' water 540# Cong. 3374  
 DST 3366-90 open 1 hr. Rec. 5' ocm  
 TD 3440 5" @ 3390 Tor. 2986  
 Sirp. 3429 CO to 3050 44/ 3042-50  
 5 go 5 gwph" 500 A PB 3008 16/ 2986-  
 90 B/ 2½ goph 500 A S/ 1½ boph  
 Comp. 51 bopd 3% water

J. G. McGEHEE