


Rooks

KANSAS

SECTION 23 TOWNSHIP 10S RANGE 19W

WELL NO. #1 Catudal "B"

COMPANY Davis Bros.

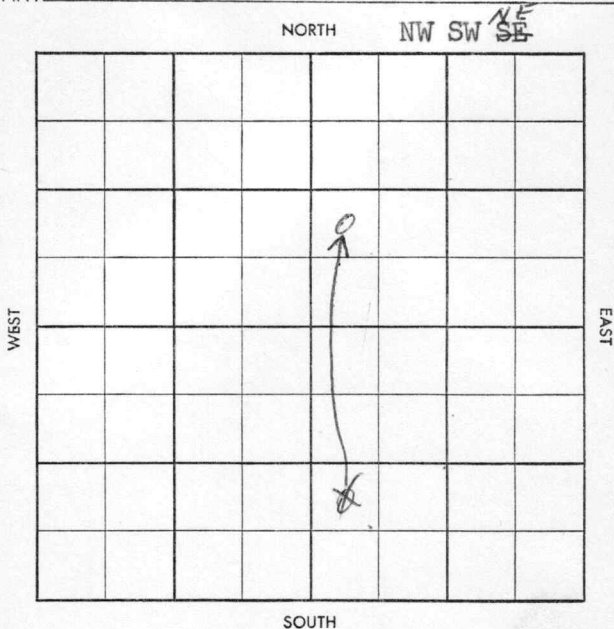

Twp. X Foot. X  
 Co. X Foot. X

# WILDCAT

S-513-B

County Rooks Elev. 2095  
 Sec. 23 Twp. 10 Rge. 19W  
 Company Davis Bros.  
 Farm Name Catudal "B" No. 1

TOPS	DEPTH	LOG	DATUM
Anh.			
Tp.			
H.			
Tr.			
Dg.			
B.L.			
L.			
K.C.			
B.K.C.			
Ce.			
C.			
M.			
M.			
K.			
Mz.			
Mq.			
V.			
S.			
S.			
A.			
R.			
Pf.			
G.			
T.D.			

Loc. in Sec. \_\_\_\_\_

NW SW SE

Geol. \_\_\_\_\_

Contr. \_\_\_\_\_

Transit

Pool \_\_\_\_\_

Wildcat

FIRST REPORT	

Date Comm. 6-21-58 SDX-1/4 mile  
8" @ 161/135 drlg. 2430

Co.

Sec.

T.

R.

CORRECTION

Twp X Pool X

Co. X Facet X

Books \_\_\_\_\_ Elev. 2075 Di: \_\_\_\_\_  
 Sec. 23 Twp. 10 Rge. 19W 3018N  
 Company Davis Bros.  
 Farm Name Catudal "B" No. 1

TOPS	DEPTH	LOG	DATUM	Loc. in Sec.
Anh.	1452			NW 3/4 N W 3/4 CK
Tp.	3039			
H.	3256	3258		
Tr.				
Dg.				
B.L.				
L.				
K.C.	3295	3299		Geol.
B.K.C.				Contr.
Ce.				Transit
C.				
M.				
M.				Pool
K.				Wildcat
Mz.				
Mq.				
V.				
S.	3600			3 4 mile ↑ ABANDONED JUL 9 '58
S.				
A.	3630			
R.				
Pf.				
G.				
T.D.	3690			

Date Comm. 6-21-58  
 8" @ 161/135 drlg. 2:30 JUL 2 '58 DST  
 3250-3320 1hr 30' M FP 38-45  
 BHP 1043-972/20" DST 3320-60  
 1hr 10' M BHP 815-380/20" DST  
 3357-3395 1hr 45' M sPK soil  
 FP 32-37 BHP 0-655/20" DST  
 3428-3500 @ 40" 30' W 6 M FP  
 65-70 BHP 1065/20" @ 350' DST 3603  
 JUL 9 '58 - 20 1hr 10' S OCS W 518' W BHP  
 990/20' log D6A