
FORM 51 25M 8-50 WESTERN Rooks KANSAS

Section 23 Township 10 Range 20 W

Well No. # 3 Rogers (B)

Company Champlin Refg.

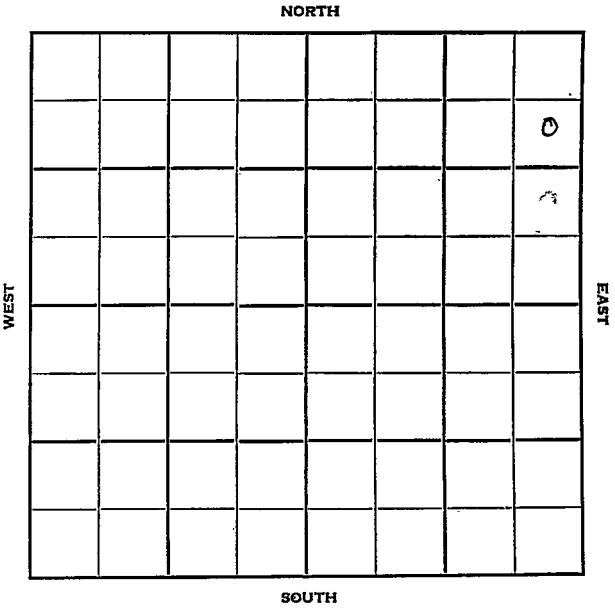

FORM 252-B
10M 10-50 PETROL

Rooks

KANSAS

Sec. 23 Twp. 10 R. 20 W

Well No. # 3 Rogers (B) Farm

Champlin Ref. Company

Champlin Contractor

Marcotte


990 Ft. from N. Line

Ft. from S. Line

330 Ft. from E. Line

Ft. from W. Line

SE NE NE

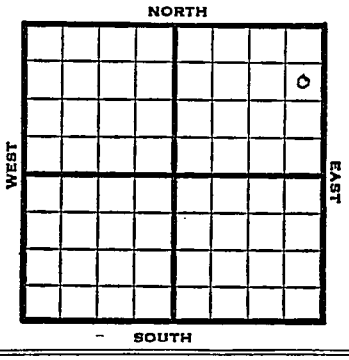

1951	Elev. 2206' REPORT
9/19	Drilling 500'
11/14	Spud 9-16-51 Oil well TD 3763' 8" @ 216' Top 3217' Heeb 3426' Tor. 3446' Lans. 3462' DST 3519-52 open 1 hr. rec 50' water & mud. Simp. 3733' DST 3735-40 open 1 hr. rec 15' mud Arb. 3755-60' 5" @ 3756' TD 3760' S/27 GOPH DD 3763' S/21 BOPH Comp. 381 BOPD COMPLETED

FORM 275 FOR SALE BY KANSAS BLUE PRINT CO.


County Rooks State Kansas

Sec. 23 (Blk. / Twp.) 10 (Sur. / Rge.) 20W Map No.

Operator Champlin Ref.

Well No. 3 Farm Rogers (B)

Elev. Location SE NE NE

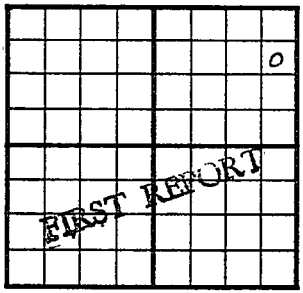

990 Ft. From N Line NE

330 Ft. From E Line Quarter

1st. Report SEP 19 1951

Completion

Remarks

Champlin - Contr.

Spudding Date

Drlg. Data Marcotte - pool

Drlg. 500

J. E. TYRA

FORM 275 FOR SALE BY KANSAS BLUE PRINT CO.


County Rooks State Kansas

Sec. 23 (Blk. Twp.) 10 (Sur. Rge.) 20W Map No.

Operator Champlin Ref.

Well No. 3 Farm Rogers "B"

Elev. 2206 Location SE NE NE

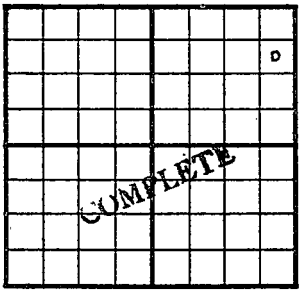

990 Ft. From N Line NE

330 Ft. From E Line Quarter

Ist. Report

Completion NOV 14 1951

Remarks Marcotte Pool

Champlin - Contr.

Spudding Date 9-16-51

Drlg. Data Oil well. TD 3763

8" @ 216 Top. 3217 Heeb. 3426

Tor. 3446 Lans. 3462 DST 3519-52

open 1 hr. Rec. 50' water & mud

Simp. 3733 DST 3735-40 open 1 hr.

Rec. 15' mud Arb. 3755-60 5" @ 3756

TD 3760 S/ 27 goph DD 3763 S/ 21 boph

Comp. 381 bopd

J. E. TYRA