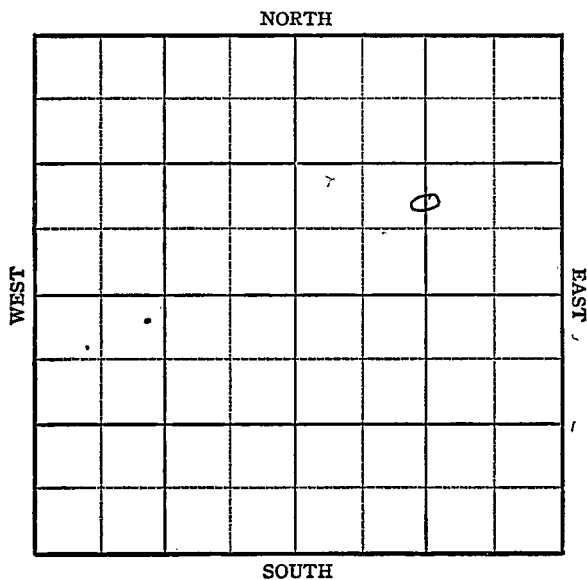


Section 23 Township 10 Range 21WWell No. #2 PierceCompany Anderson-Prichard

Graham
10

Sec. 23 Twp. 10 R. 21W

Well No. #2 Pierce Farm

Anderson-Prichard Company

Contractor

Morland Pool


 Ft. from N. Line

990' Ft. from S. Line

1320' Ft. from E. Line

 Ft. from W. Line

C N L S $\frac{1}{2}$ NE

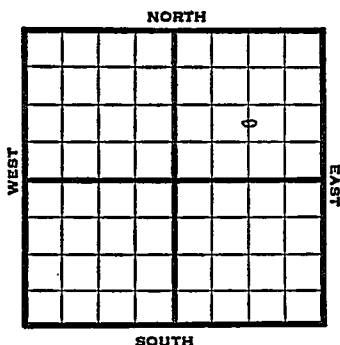

1951 Elev. 2170' REPORT

5/29 Location

7/11 Spud 6-9-51
Oil Well TD 3740
8" @ 279 Heeb. 3393
Lans. 3433 Arb. 3732-40
5" @ 3737 TD 3740
S/1 $\frac{1}{2}$ booh 10 hr. 500 A
S/8 boph
DST 3732-40 opn 1 hr Rec. 100'
hocm 10' oil Comp. 221 bopd

COMPLETED

County Graham State Kansas
 Sec. 23 (Blk. Twp.) 10 (Sur. Rge.) 21W Map No. _____
 Operator Anderson - Prichard
 Well No. 2 Farm Pierce
 Elev. _____ Location C N L S $\frac{1}{2}$ NE

990 Ft. From Sth Line NE

1320 Ft. From E Line Quarter

Ist. Report MAY 29 1951

Completion _____

Remarks _____

Spudding Date _____


Drig. Data _____

Morland Pool

Location

J. E. TYRA

County Graham State Kansas
 Sec. 23 (Blk. 10 (Sur. 21W Map No.
 (Twp. (Rge.
 Operator Anderson - Prichard
 Well No. 2 Farm Pierce
 Elev. 2170 Location C N L S $\frac{1}{2}$ NE

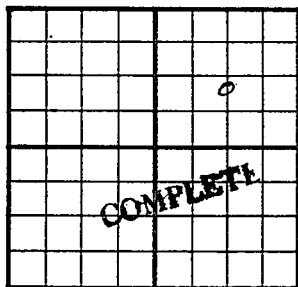

990 Ft. From S Line NE
1320 Ft. From E Line Quarter
 Ist. Report
 Completion JUL 11 1951
 Remarks Morland Pool
Peel Drlg. - Contr.
 Spudding Date 6-9-51

Drlg. Data Oil well TD 3740
8" @ 279 Heeb. 3393 Lans. 3433
Arb. 3732-40 5" @ 3737 TD 3740
S/ 1 $\frac{1}{2}$ booh 10 hr. 500 A S/ 8 bopd
DST 3732-40 open 1 hr. Rec. 100'
hocm 10' oil Comp. 221 bopd