


Section 23 Township 10 Range 21 W

Well No. # 2 Pierce

Company Derby Oil et al

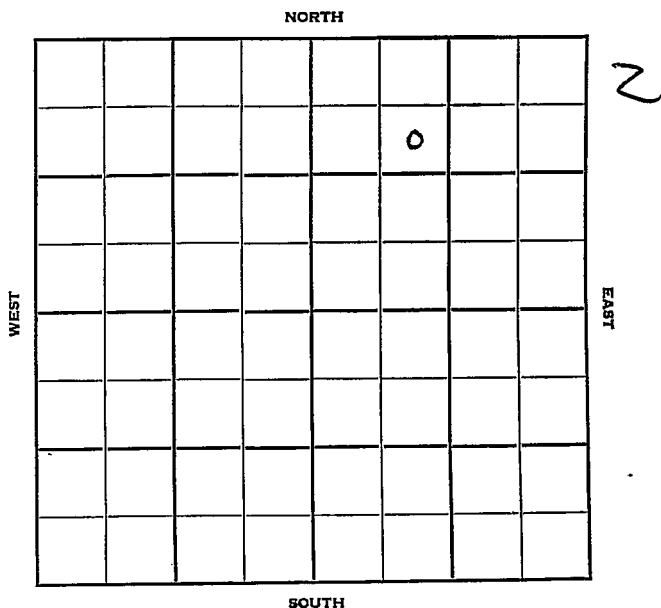

Sec. 23 Twp. 10 R. 21 W

Well No. #2 Pierce Farm

Derby Oil et al Company

Peel Contractor


990 Morland
Ft. from N. Line

Ft. from S. Line

Ft. from E. Line

990 Ft. from W. Line

SE NW NE

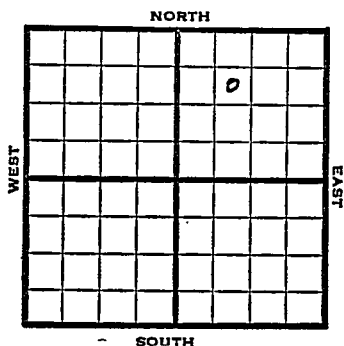

1951 Elev. 2189' REPORT

2/28 Location

4/11 Spud 3-3-51
Oil well TD 3740'
8" @ 275 Heeb 3402', Lans 3440'
Arb. 3735-40,
4 1/2" @ 3736 TD 3740'
S/3 BOPH 500 A S/ 12 BOPH
Comp. 348 BOPD

COMPLETED

County Graham State Kansas
 Sec. 23 (Blk.) 10 (Sur.) 21W Map No.
 Operator Derby Oil etal.
 Well No. 2 Farm Pierce
 Elev. _____ Location SE NW NE

FIRST REPORT

990 Ft. From N Line NE
990 Ft. From W Line Quarter
 1st. Report FEB 28 1951
 Completion _____
 Remarks _____
Peel - Contr.
 Spudding Date _____

Drig. Data Morland Pool
Location

J. E. TYRA

County Graham State Kansas
 Sec. 23 (Blk. 10 (Sur. 21W Map No.
 (Twp.) (Rge.)
 Operator Derby Oil et al.
 Well No. 2 Farm Pierce
 Elev. 2189 Location SE NW NE

990 Ft. From N Line NE

990 Ft. From W Line Quarter

1st. Report

Completion APR 11 1951

Remarks Morland Pool

Peel - Contr.

Spudding Date 3-3-51

Drlg. Data Oil well TD 3740

8" @ 275 Heeb. 3402 Lans. 3440

Arb. 3735-40 $4\frac{1}{2}$ " @ 3736 TD 3740

S/ 3 boph 500 A S/ 12 boph

Comp. 348 bopd

J. E. TYRA