


KANSAS

Graham

Section 23 Township 10 Range 21-WWell No. #1 PierceCompany Anderson-PrichardBerland Pool

NORTH

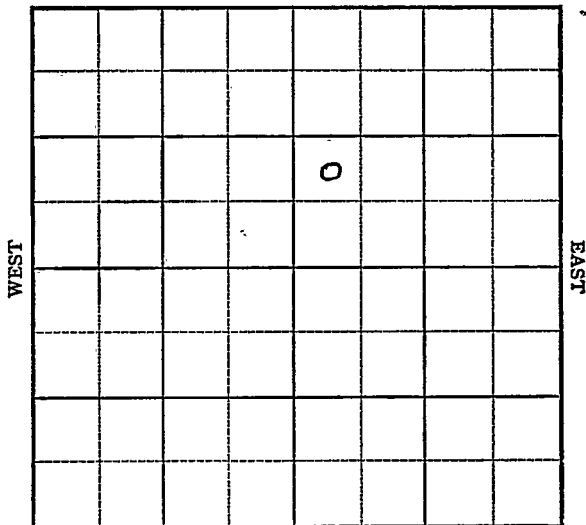

SOUTH

KANSAS

Graham ✓

Sec. 23 Twp. 10 R. 21W


Well No. 1 Pierce Farm

Anderson-Prichard Company

Berland Pool

Peel Contr.

NORTH

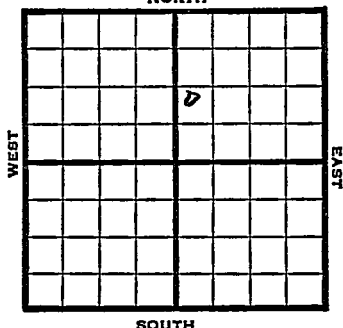

 Ft. from N. Line

990 Ft. from S. Line

 Ft. from E. Line

330 Ft. from W. Line

NW SW NE

SOUTH

1949 Elev 2187' REPORT

8/24 8" @ 277'
Anhy 1652
Drlg 1950

8/31 Lansing 3452'
Arbuckle 3754'
TD 3758'
5" @ 3755'

9/7 TD 3760' -
2000 acid
Swb 33 bbls oil & 52 W 24 hrs.

9/14 PB 3758'

9/21 "

9/28 "

10/5 "

10/12 TD 3760'
Lans 3452'
Arb. 3754'
5"@ 3755'
2000 acid
Pump 12 oil / 80% W Pot
27° Gr.
Comp

COMPLETED

Map No. _____ Sec. 23 Twp. 10 R. 21W

Well No. 1 Pierce

_____ Anderson-Prichard _____ Company

_____ Peel _____ Contractor

NW SW NE


**FIRST REPORT
 SECTION FLAT**

_____ Ft. from N. Line

990 Ft. from S. Line

_____ Ft. from E. Line

330 Ft. from W. Line

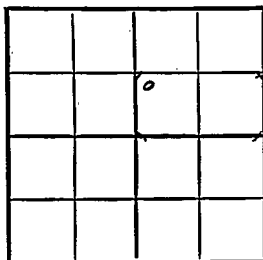

Graham County

RECORD

Location _____

Cased _____ in., _____ ft.

Rig up _____

Sand _____

Drilling and Remarks: _____

Gas _____

8" @ 277

Oil _____

Anhy 1652

Total Depth _____

drlg. 1950

PRODUCTION

1st 24 hrs. Nat. _____

1st 24 hrs. after shot _____

Gas _____ Cu. Ft.

Dry Hole _____

Abandoned _____

Date

AUG 24 1949 19

S. J. LEWIS Scout

Map No. _____ Sec. 23 Twp. 10 R. 21W

Well No. 1 Pierce

Anderson-Prichard

Company

COMPLETE

Contractor

NW SW NE

E 12187
SECTION PLAT

		0	

_____ Ft. from N. Line

990 Ft. from S. Line

_____ Ft. from E. Line

330 Ft. from W. Line

Graham County

RECORD

Location _____

Cased _____ in., _____ ft.

Rig up _____

Sand _____

Drilling and Remarks:

Gas _____

Line 3452

Oil _____

Cr 43254

Total Depth 2760

5" 2753.

PRODUCTION

1st 24 hrs. Nat. _____

1st 24 hrs. after shot _____

Gas _____ Cu. Ft.

Dry Hole _____

Abandoned _____

2660 acid

Prod. 12 oil + 80% gas

Bo 27 2/3

Date

OCT 12 1949

19

S. J. LEWIS

Scout