


Graham

KANSAS

Section 23 Township 10 Range 22WWell No. #1 WatkinsCompany Kantor et al

NORTH

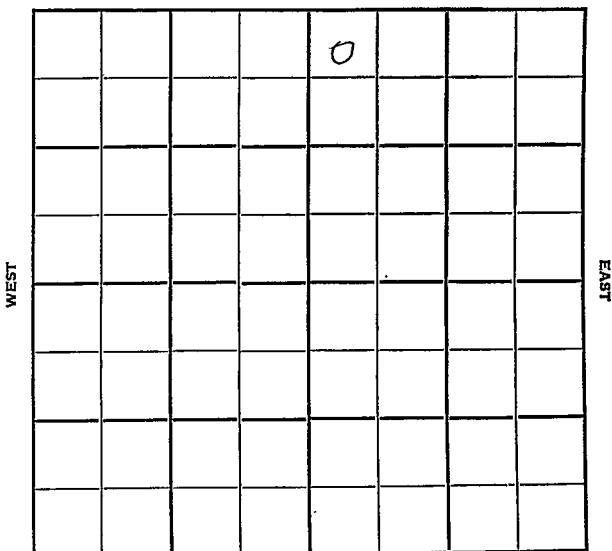

SOUTH

Graham

Sec. 23 Twp. 10 R. 22W

Well No. #1 Watkins Farm ☒

Kantor et al Company

B & B Drlg. - Contr. Contractor


Wildcat
330' Ft. from N. Line

 Ft. from S. Line

 Ft. from E. Line

330' Ft. from W. Line

NW NW NE

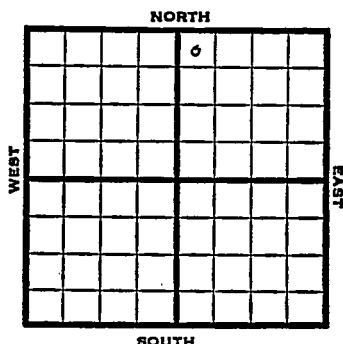

1950

Elev 2257'

REPORT

12/13

Spud 12-8-50
8" @ 174'
Anhy 1750
Drlg. 2230'

12/20

8" @ 174
Anhy 1750
Lans 3534
Cong 3868
TD 3929'
D&A

Heeb 3495
Marmaton 3826
Arb 3903-29 TD

ABANDONED

County Graham State KansasSec. 23 (Blk. Twp.) 10 (Sur. Rge.) 22W Map No.Operator Kantor et al.Well No. 1 Farm WatkinsElev. Location NW NW NE

FIRST REPORT


330 Ft. From N Line NE330 Ft. From W Line Quarter1st. Report DEC 13 1950

Completion

Remarks

B & B Drlg. - Contr.Spudding Date 12-8-50Drlg. Data Wildcat8" @ 174 Anhy 1750 drlg. 2230

J. E. TYRA

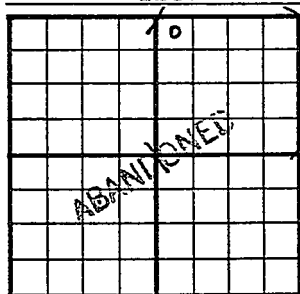County Graham State KansasSec. 23 (Blk. Twp.) 10 (Sur. Rge.) 2 2W Map No.Operator Kantor et al.Well No. 1 Farm WatkinsElev. 2257 Location NW NW NE330 Ft. From N Line NE330 Ft. From W Line Quarter

1st. Report

Completion DEC 20 1950Remarks WildcatB & B Drlg. - Contr.Spudding Date 12-8-50Drlg. Data D & A TD 39298" @ 174 Anhy 1750 Heeb. 3495Trans. 3534 Marmaton 3826 Cong. 3868Arb. 3903-29 TD D & A