
WELL LOG BUREAU—KANSAS GEOLOGICAL SOCIETY
508 East Murdock, Wichita, Kansas 15-065-00760

Company. TRANS ERA PETROLEUM, INC.
Farm. Klenk No. 1

SEC. 3 T. 10 R. 23W
SW SW SW

Total Depth. 4174'
Comm. 4-3-55 Comp. 4-18-55
Shot or Treated.
Contractor.
Issued. 3-17-56

County Graham

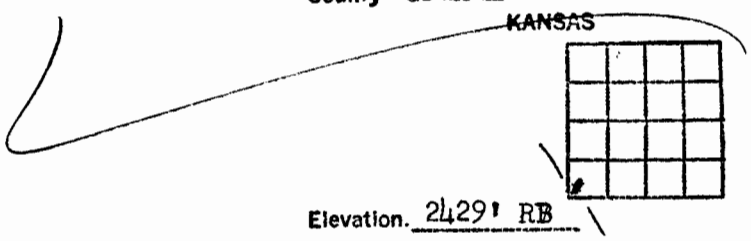

CASING:
8 5/8" 226' cem w/160 sx

Elevation. 2429' RB

Production. Dry

Figures Indicate Bottom of Formations.

surface clay & shale	70
sand & shale	125
shale, sand & shells	190
shale & shells	265
sand & shale	400
shale & shells	560
shale	710
shale & shells	1260
sand	1310
shale	1370
shale & red bed	1440
sand	1515
sand & shale	1950
red bed & shale	2005
anhydrite	2040
shale & shells	2310
shale & lime	3494
lime	3547
shale & lime	3744
lime	3975
lime & shale	4174
Total Depth	

Tops: Scout	
Anhydrite	2005
Heebner	3711
Kansas City	3744
Base Kansas City	3972
Marmaton	4088
Mississippi Sand	4162
Conglomerate	4171