


WELL LOG BUREAU--KANSAS GEOLOGICAL SOCIETY
508 East Murdock, Wichita, Kansas

15-065-72178 ✓

Company- MARCH DRLG. CO.
Farm- Dietz No. 2

SEC. 8 T. 10 R. 23W
NW NW NW

Total Depth. 4025'
Comm. 9-12-64 Comp. 9-23-64
Shot or Treated.
Contractor. Co. Tools
Issued. 1-2-65

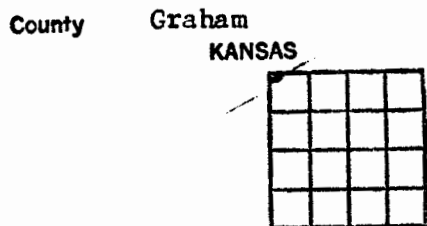

Elevation. 2431' R.B.

Production. Input well.

CASING:

8 5/8" 182' w/140 sx cem.
5 1/2" 2040' w/150 sx cem.

Figures Indicate Bottom of Formations.

COMPLETE DRILLERS LOG NOT AVAILABLE.

Rare trace of light brown oil stain in white crystalline limestone. No odor & no free oil in wet samples. Saturation spotted. Low porosity. This zone is of no commercial value.

3787-3789'

DST # 2 - 3942' - 3997' Op. 1 hr.
Blow weak throughout test. Rec. 55' of drilling mud. IBHP 313#/1 hr. IFP 32#; FFP 43#; FBHP 194#/1 hr.

Ran Great Guns log.

Very rare tr. of spotted light brown oil stain in buff oolitic limestone. No odor & no free oil in wet samples. This zone is of no commercial value.

3827-3829'

Rare tr. of brown oil stain in buff crystalline to matted oolitic limestone. No odor & no free oil in wet samples. Traces of pinpoint porosity. This zone is of no commercial value.

3861-3883'

Scattered light brown oil stain in buff crystalline & oolitic limestone. Saturation fair. No odor and no free oil in wet samples. Traces of pinpoint. This zone covered by drill stem test #1. This zone is of no commercial value.

3942'-3965'

Trace of light brown oil stain in buff crystalline limestone. No odor and no free oil in wet samples. Low order porosity. Saturation spotted. This zone covered by drill stem test #2. This zone is of no commercial value.

3959'-3962'

Occasional light brown oil stain in buff crystalline. No odor and no free oil in wet samples. Saturation spotted. Traces of pinpoint porosity. This zone covered by drill stem test #2. This zone is of no commercial value.

3978'-3982'

TOTAL DEPTH 4025

TCPS:

*Cheyenne (Sc)	1715
Anhydrite	2035
Topeka	3530
Heebner	3738
Toronto	3770
Lansing Kansas City	3786

DST # 1 - 3930'-3952' Op. 1 hr..
Blow, weak flow for 10 min. Rec. 20' drilling mud. IBHP 32#/1 hr. IFP 15#; FF) 23#; FBHP 28#/1 hr.