

KANSAS


Rooks

Section 24 Township 10 Range 18WWell No. 1 ShepardCompany Anschutz

Wildcat

NORTH

WEST

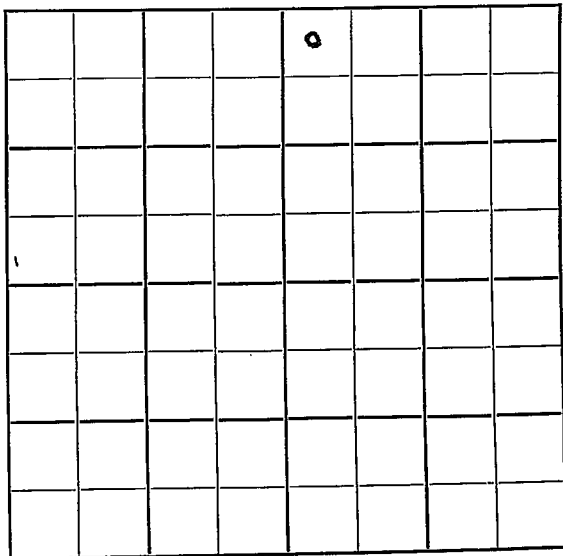

EAST

SOUTH

Rooks KANSAS

Sec. 24 Twp. 10 R. 18W

Well No. #1 Shepard Farm

Anschutz

Company

Wildcat (Anschutz, Cont.)

NORTH

330'

Ft. from N. Line


Ft. from S. Line

Ft. from E. Line

330'

Ft. from W. Line

NW NE

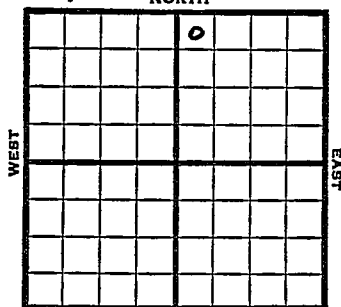

SOUTH

1949

Elev 2111' REPORT

8/31

Location

9/7

8" @ 195'

Dr1g. 2556'

9/14

TD 3716'

Lans 3341'

Cong 3600'

Simp 3667'

Arb. 3699'

Aband.

ABANDONED

Map No. _____ Sec. 24 Twp. 10 R. 18W

Well No. 1 Shepard

Anschutz Company

Anschutz Contractor

NW NE


FIRST REPORT
SECTION PLAT

330 Ft. from N. Line

_____ Ft. from S. Line

_____ Ft. from E. Line

330 Ft. from W. Line

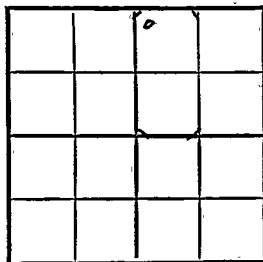

Rooks County

Location X

Rig up

Drilling and Remarks:

RECORD

Cased _____ in., _____ ft.

Sand _____

Gas _____

Oil _____

Total Depth _____

PRODUCTION

1st 24 hrs. Nat. _____

1st 24 hrs. after shot _____

Gas _____ Cu. Ft.

Dry Hole _____

Abandoned _____

Date

AUG 31 1949

19

J. J. LEWIS

Scout

Map No. K164 Sec. 24 Twp. 10 R. 18W

Well No. 1 Shepard

Anschutz

Company

ABANDONED

Contractor

NW NE

E12111


SECTION PLAT

330 Ft. from N. Line

_____ Ft. from S. Line

_____ Ft. from E. Line

330 Ft. from W. Line

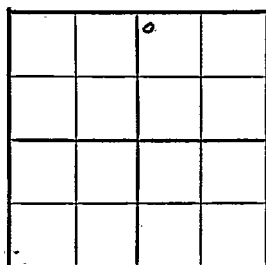

Rooks County

Location _____

Rig up _____

Drilling and Remarks:

Loc 8841
Core 3600
Core 3667
Core 3699

RECORD

Cased _____ in., _____ ft.

Sand _____

Gas _____

Oil _____

Total Depth 3216

PRODUCTION

1st 24 hrs. Nat. _____

1st 24 hrs. after shot _____

Gas _____ Cu. Ft.

Dry Hole _____

Abandoned _____

Date

SEP 14 1949

19

S. J. LEWIS

Scout