


Section 24 Township 10 Range 19WWell No. 1 GasawayCompany Palmer Oil

NORTH

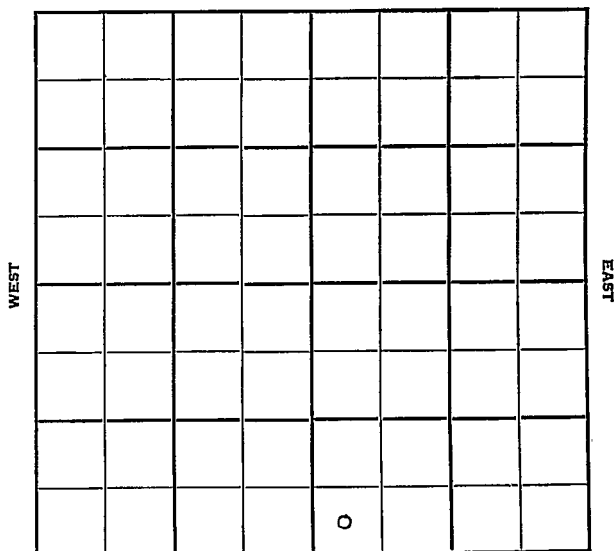


SOUTH

Rooks

KANSAS

Sec. 24 Twp. 10 R. 19 WWell No. # 1 Gasaway FarmPalmer Oil CompanyBraden Drlg. ContractorWildcat Ft. from N. Line330 Ft. from S. Line Ft. from E. Line330 Ft. from W. Line

SW SW SE

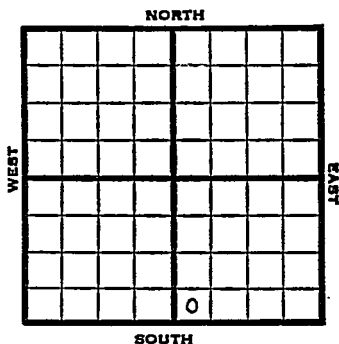

1951

Elev. 2017'

REPORT

8/1

Spud 7-20-51

8" @ 223

Anhy 1370-1415'

Lost circ @ 3190'

Drlg. 3225'

8/8

Spud 7-20-51

D&A TD 3588

8" @ 223

Anhy 1370-1415 Heeb. 3174

Lans. 3215 BKG 3454

Cong. 3512 Re-Arb. 3544

Arb. 3586-88 TD

D&A

ABANDONED

County **Rooks** State **Kansas**

Sec. 24 (Blk. Twp.) 10 (Sur. Rge.) 19W Map No.

Operator Palmer Oil

Well No. 1 Farm Gasaway

Elev.	2017	Location	SW	SW	SE
-------	------	----------	----	----	----

FIRST REPORT

330 Ft. From S Line SE

330 Ft. From W Line Quarter

1st. Report AUG 1 1951

Completion

Remarks

Braden Drig. - Contr.

Spudding Date 7-20-51


Drig. Data Wildcat

8" @ 223 Anhy 1370-1415 lost circ @3190

drlg. 3225

J. E. TYRA

County _____ Rooks _____ State Kansas
 Sec. 24 (Blk.) 10 (Sur.) 19W Map No. _____
 Operator Palmer Oil
 Well No. 1 Farm Gasaway
 Elev. 2017 Location SW SW SE

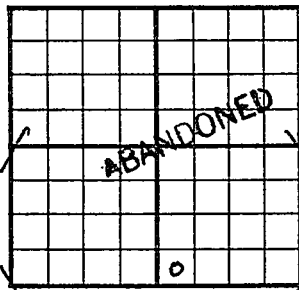

330 Ft. From S Line SE
330 Ft. From W Line Quarter
 1st. Report _____
 Completion AUG 8 1951
 Remarks Wildcat
Braden Drlg. - Contr.
 Spudding Date 7-20-51

Drlg. Data D & A TD 3588
8" @ 223 Anhy 1370-1415 Heeb. 3174
Lans. 3215 'B KC 3454 Cong. 3512
ReArb. 3544 Arb. 3586-88 TD
D & A

J. E. TYRA