


Section 24 Township 10 Range 19 W

Well No. # 1 - Vohs

Company Lewis Drilling

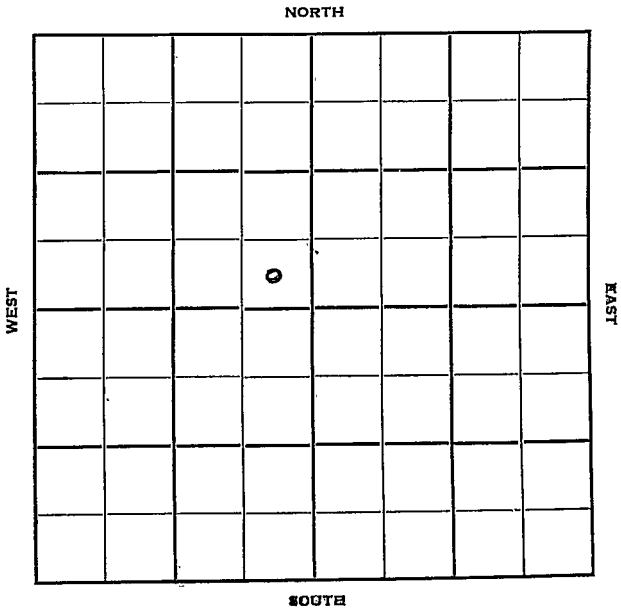

KANSAS

Rooks

Sec. 24 Twp. 10 R. 19W

Well No. #1 Vohs Farm

Lewis Drlg Company

Contractor

Wildcat


 Ft. from N. Line

330 Ft. from S. Line

330 Ft. from E. Line

 Ft. from W. Line

SE SE NW

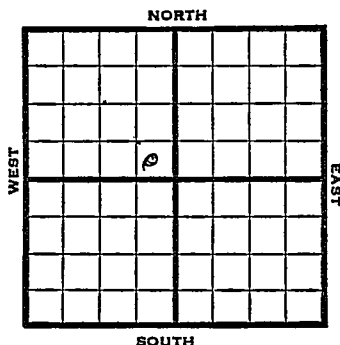

1950

Elev. 2073' REPORT

5/10

Spud 5-7-50
8 5/8 @ 181
Drlg. 1450

5/24

8-5/8" @ 181'
Topeka 3021' Heebner 3237'
Dodge 3257' Lans. 3278'
DST 3572-76 opn 25 min
Rec. 8" mud
Cong. 3583'
Simp. 3597'
Arb. 3610-50 TD
NS TD 3650'
D&A

ABANDONED

Kansas

Map No. _____ Sec. 24 Twp. 10 R. 19W

Well No. _____ 1 Vohs

Lewis Drlg. _____ Company

Contractor

SE SE NW


SECTION PLAT

_____ Ft. from N. Line

330 _____ Ft. from S. Line

330 _____ Ft. from E. Line

_____ Ft. from W. Line

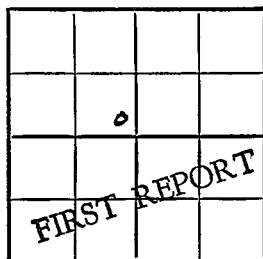

Rocks

Derby DHM

Location _____

Rig up _____

Drilling and Remarks:

Spud 5-7-50

8 5/8 @ 181

Drlg. 1450

RECORD

Cased _____ in., _____ ft.

Sand _____

Gas _____

Oil _____

Total Depth _____

PRODUCTION

1st 24 hrs. Nat. _____

1st 24 hrs. after shot _____

Gas _____ Cu. Ft.

Dry Hole _____

Abandoned _____

Date

MAY 10 1949

J. E. TYRA Scout

Kansas

Map No. _____ Sec. 24 Twp. 10 R. 19WWell No. 1 VohsLewis Drilling Company

Contractor


SE SE NW

E1.2073
SECTION PLAT

_____ Ft. from N. Line

330 Ft. from S. Line330 Ft. from E. Line

_____ Ft. from W. Line

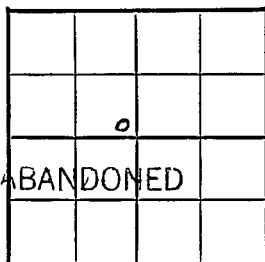

ABANDONED

Rocks

Location _____

Rig up _____

Drilling and Remarks:

8 5/8" c 181
 Lopezka 3021
 Hubner 3237
 Dodge 3257
 Lana. 3278
 DST 3572-76
 open 25 min.
 Rec. 8" mud

RECORD

Cased _____ in., _____ ft.

Sand _____

Gas _____

Oil _____

Total Depth 3650

PRODUCTION

1st 24 hrs. Nat. _____

1st 24 hrs. after shot _____

Gas _____ Cu. Ft.

Dry Hole _____

Abandoned _____

Date

MAY 24 1950

19

J. E. TYRA Scout

Cong. 3583
 Ship. 3597
 Arb. 3610-50 T.D.
 n.s. D + A

Scout Cards
Land Small Map
Land Wall Map
Tracings
France Map
Pierce Map
Misc.

JUN 5 1950
