

Section 24 Township 10 Range 20WWell No. #9 SutorCompany Morris Sitrin

NORTH

							0

WEST

EAST

SOUTH

Rooks

KANSAS

Sec. 24 Twp. 10 R. 20WWell No. #9 Sutor FarmMorris Sitrin Company

Contractor


990 Ft. from N. Line

Ft. from S. Line

330 Ft. from E. Line

Ft. from W. Line

SE NE NE

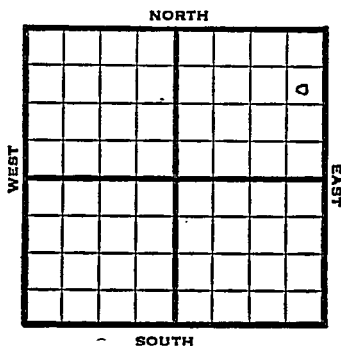

1952

Elev. 2221' REPORT

3/26 Location

4/1 "

4/9 "

4/23 C & P

4/30 8" @192' Anhy 1590
 Heeb. 3426 Lans. 3464 Arb. 3770
 RTD 3773 5" @

5/7 WOCT

5/14 DP Shut down

5/21 POP

5/28 DP CO 3740' 24/3598-3604 1000 A
 S/1½ BOPH PB 3590' 16/3556-60
 1000 A S/1-3/4 BOPH Set plug 3540'
 24/3498-3504 1000 A S/3 BOPH
 DP 3738' POP

6/11 NR

6/18 NR

6/25 NR

7/2 "

7/9 "

OVER

1952
7/16

Spud 4-16-52

Oil well TD 3773' 8" @ 192

Anhy 1590' Heeb 3426' Lans. 3464'

Arb. 3770' TD 3773' 5" @ 3770

CO to 3740 24/3598-3604 1000 A

S/1 $\frac{1}{2}$ BOPH PB 3590 16/3556-60

1000 A S/1-3/4 BOPH SP 3540

24/3498-3504 1000 A S/3 BOPH

DP to 3738

Compl 105 BOPD 20% water.

COMPLETED

Sec. **24** (Blk. **10** (Sur. **20W** Map No.

Well No. **9** Farm **Sutor**

Elev.	Location	SE	NE	NE
-------	----------	----	----	----

FIRST REPORT

990 Ft. From **N** Line **NE**

330 Ft. From E Line Quarter

1st. Report MAR 26 1952

Completion _____

Remarks _____

Spudding Date _____

Drlg. Data

Location

J. G. McGEHEE

County	Rooks		State		Kansas
Sec.	24	(Blk. Twp.)	10	(Sur. Rge.)	20W Map No.

Operator Morris Sitrin

Well No. 9 Farm Sutor

Elev.	2221	Location	SE NE NE
-------	------	----------	----------

990 Ft. From N Line NE

330 Ft. From E Line Quarter

1st. Report

Completion JUL 16 1952

Remarks

Spudding Date 4-16-52

Drig. Data Oil well TD 3773

8" @ 192 Anh v 1590 Heeb. 3426

Lans. 3464 Arb., 3770 TD 3773

5" @ 3770 60 to 3740 24/ 3598-3604

1000 A S/ $1\frac{1}{2}$ boph PB 3590 16/ 3556-

60 1000 A S/ 1 3/4 boph SP 3540

24/ 3498-3504 1000 A S/ 3 boph

DP to 3738 Comp. 105 bopd 20% water

J. G. McGEHEE