


Section 24 Township 10 Range 20WWell No. #6 Sutor "A"Company Birmingham & Bartlett

Berland Pool

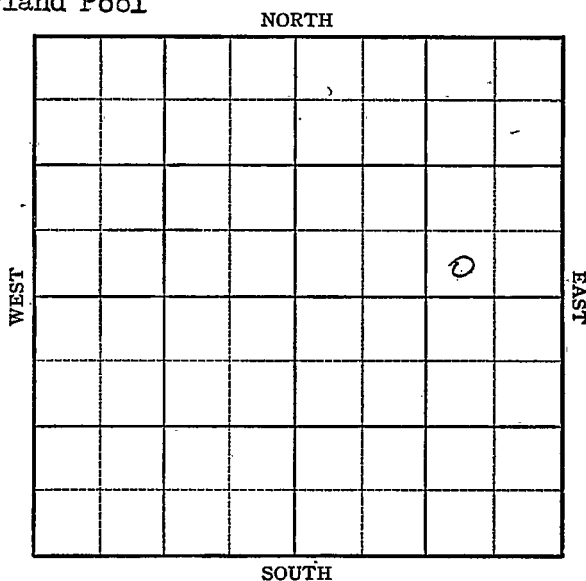

Rooks

KANSAS


Sec. 24 Twp. 10 R. 20W

Well No. #6 Sutor "A" Farm

Birmingham & Bartlett

Berland Pool (Birmingham & Bartlett, Contr.) Company

NORTH

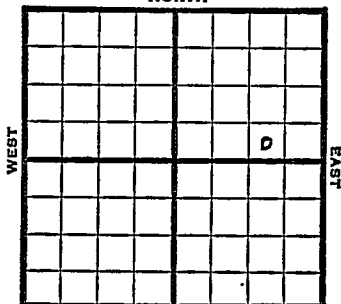

Ft. from N. Line

330'

Ft. from S. Line

990'

Ft. from E. Line

Ft. from W. Line

SW SE NE

SOUTH

1949

Elev 2227'

R E P O R T

12/7

8" @ 187'

12/14

"

12/21

Lansing 3478'

Arb. 3788-90'

TD 3790'

5"@ 3789'

12/28

TD 3794'

Swb 4 bbls oil PH

1950

1/11

TD 3505'

8"@ 187'

5"@ 3789'

PP 166 BOPD

No wtr.

Lan 3478'

Cong 3715'

Simp 3766'

Arb. 3788'

Comp

COMPLETED

Map No. _____ Sec. 24 Twp. 10 R. 20W

Well No. 6 Sutor "A"

_____ Birmingham & Bartlett Company

_____ Birmingham & Bartlett Contractor

SW SE NE

**FIRST REPORT
 SECTION PLAT**

_____ Ft. from N. Line

330

_____ Ft. from S. Line

990

_____ Ft. from E. Line

_____ Ft. from W. Line

Rooks. County

Location _____

Rig up _____

Drilling and Remarks:

8" @ 187

RECORD

Cased _____ in., _____ ft.

Sand _____

Gas _____

Oil _____

Total Depth _____

PRODUCTION

1st 24 hrs. Nat. _____

1st 24 hrs. after shot _____

Gas _____ Cu. Ft.

Dry Hole _____

Abandoned _____

Date

DEC 7 1949 19

S. J. LEWIS Scout

Kansas

Berland Pool

Map No. _____ Sec. 24 Twp. 10 R. 20WWell No. 6 Sutor "A"Birmingham & Bartlett Company

SW SE NE

Contractor

Elev. 2227
SECTION PLAT Ft. from N. Line330 Ft. from S. Line990 Ft. from E. Line Ft. from W. Line

COMPLETE			
			o

Rooks County

RECORD

Location _____

Cased _____ in., _____ ft.

Rig up _____

Sand _____

Drilling and Remarks:

Gas _____

Oil _____

Total Depth 3505

PRODUCTION

1st 24 hrs. Nat. _____

1st 24 hrs. after shot _____

Gas _____ Cu. Ft.

Dry Hole _____

Abandoned _____

Date

J. E. TYRA

JAN 11 1950₁₉

Scout

San 3478
Cang 3715
Seng 3766
Ans 3788

JAN 16 1950

Scout Cards *Earth*
Land Small Map
Land Wall Map *3*
Tracings
France Map
Pierce Map
Misc.