


Section 24 Township 10 Range 20

Well No. #10 Sutor "A"

Company Morris Sitrin Company

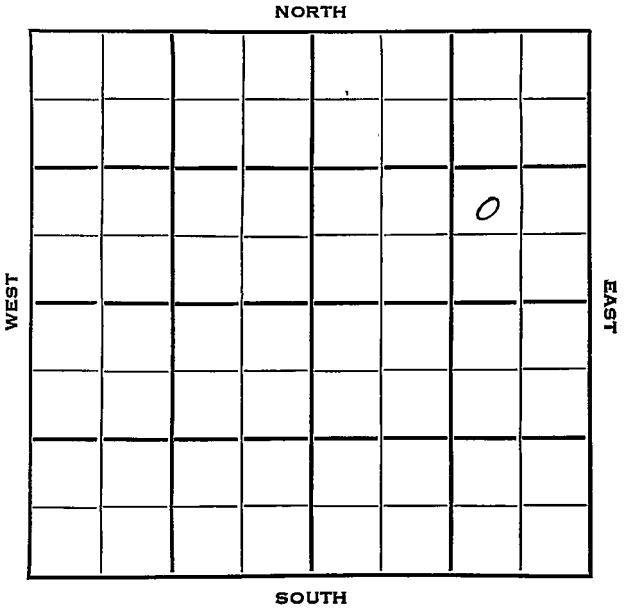

Sec. 24 Twp. 10 R. 20W

Well No. #10 Sutor "A" Farm

Morris Sitrin Company


Murfin Drlg. Contr. Contractor

 Ft. from N. Line

990 Ft. from S. Line

990 Ft. from E. Line

 Ft. from W. Line

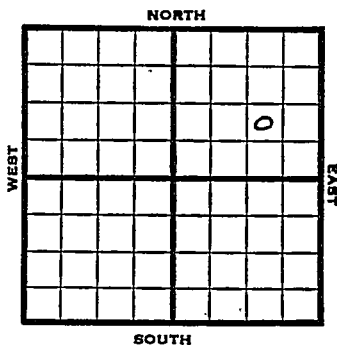

NW SE NE

1953

Elev. 2212'

REPORT

3/4 Drlg. 2675

3/12 Drlg. 3771'

3/19 Arb. 3765' TD 3830'
5" @ 3830'

3/26 12/3767-71, 12/3770-73, 500A
S/2 BO + 1 BWPH

4/2 NR

4/9 "

4/16 "

4/23 NR

4/30 "

5/6 Oil well TD 3835 8" @ 192
Heeb 3422 Tor 3445 Lans 3460
DST 3480-3507 open 1/2 hr rec 195' wtr.
Cong 3697 Simp 3745
12/3767-71 12/3770-73 1000 A
S/1 BW 2 BOPH Arb. 3767 TD 3835
5" @ 3835 CO to 3801 3 1/2 BO 1 1/2 BWPH
Comp. 144 BOPD 10% wtr.

COMPLETED

