FORM 51 10M 2-49 PETROL


KANSAS Rooks

Section 24 Township 10 Range 20-W

Well No. #4 Sutor "A"

Company Birmingham & Bartlett

Berland Pool

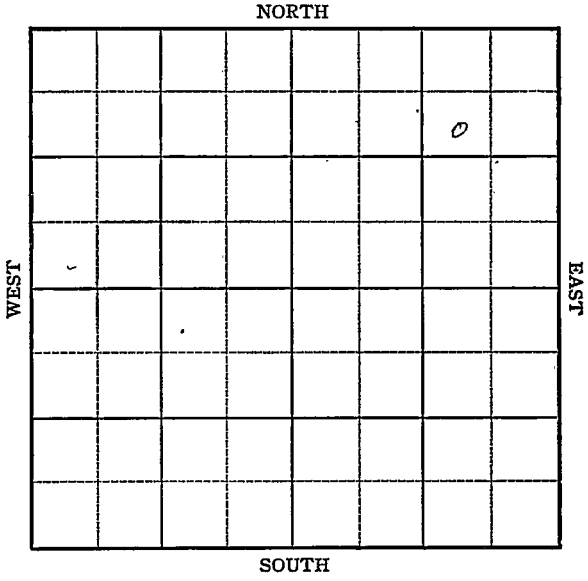

FORM 252-B
10M 9-49 PETROL

Rooks KANSAS

Sec. 24 Twp. 10 R. 20W

Well No. #4 Sutor "A" Farm

Birminghan & Bartlett Company

B & R Contractor

Berland Pool


990' Ft. from N. Line

Ft. from S. Line

990' Ft. from E. Line

Ft. from W. Line

SW NE NE

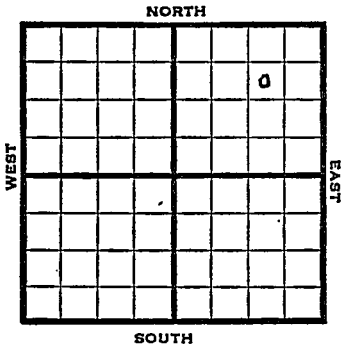

1949	Elev 2198' REPORT
11/9	RUR
11/16	10"@ 164'
	Drlg 3828'
11/23	Lansing 3441'
	Simpson 3727'
	Arb. 3747-49'
	TD 3749'
	5"@ 3749'
11/29	TD 3753'
	Pump 9 bbls oil PB 500 acid
12/7	TD 3753'
	Arb. 3747'
	5"@ 3749'
	500 acid
	Pump 518 Oil Pot
	27° Gr.
	Comp
	COMPLETED

Form 26 200 Bks. 6-49 Petrol

Kansas

Berland Pool

Map No. ____ Sec. 24 Twp. 10 R. 20W

Well No. 4 Sutor "A"


Birmingham & Bartlett Company

B & R Contractor

SW NE NE

FIRST REPORT

SECTION PLAT

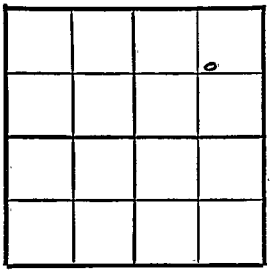

990 Ft. from N. Line

____ Ft. from S. Line

990 Ft. from E. Line

____ Ft. from W. Line

Rooks County

Location ____

Rig up ____

Drilling and Remarks:

R U R

RECORD

Cased ____ in., ____ ft.

Sand ____

Gas ____

Oil ____

Total Depth ____

PRODUCTION

1st 24 hrs. Nat. ____

1st 24 hrs. after shot ____

Gas ____ Cu. Ft.

Dry Hole ____

Abandoned ____

Date

NOV 9 1949 19

S. J. LEWIS Scout

Form 26 200 Bks. 6-49 Petrol

Kansas

Berland Pool

Map No. _____ Sec. 24 Twp. 10 R. 20W

Well No. 4 Sutor "A"


Birmingham & Bartlett Company

COMPLETE Contractor

SW NE NE

E 1.2198

SECTION PLAT

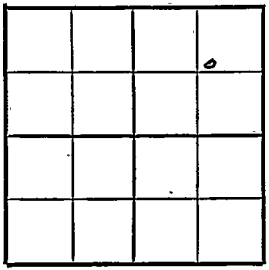

990 Ft. from N. Line

Ft. from S. Line

990 Ft. from E. Line

Ft. from W. Line

Rooks County

Location _____

Rig up _____

Drilling and Remarks:

Cir 3349

5" @ 3344

500 Gal

Pmp 5/8 Oil Bet

27 Hr.

RECORD

Cased _____ in., _____ ft.

Sand _____

Gas _____

Oil _____

Total Depth 3353

PRODUCTION

1st 24 hrs. Nat. _____

1st 24 hrs. after shot _____

Gas _____ Cu. Ft.

Dry Hole _____

Abandoned _____

Date

DEC 7 1949 19

S. J. LEWIS Scout