


Section 24 Township 10 Range 20W

Well No. #1 Sutor (B)

Company Gulf Oil

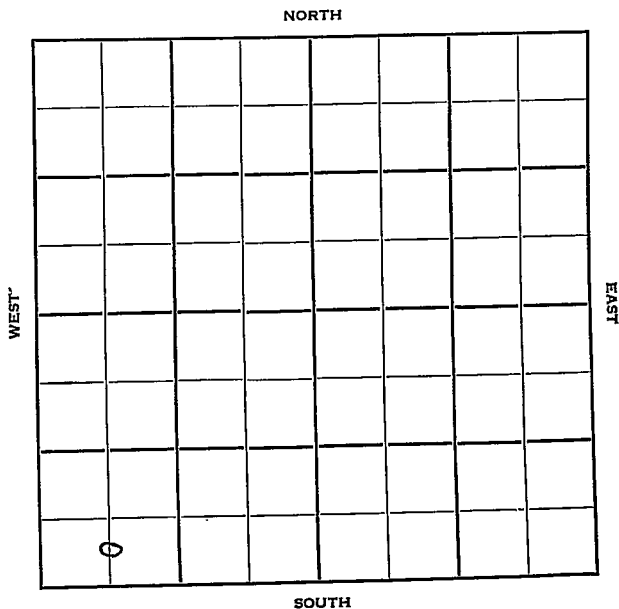

Sec. 24 Twp. 10 R. 20W 1

Well No. #1 Sutor (B) Farm

Gulf Oil Company

Contractor


Ft. from N. Line

330 Ft. from S. Line

Ft. from E. Line

660 Ft. from W. Line

C S/2 SWSW

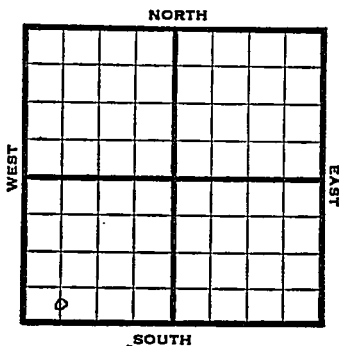

1952 Elev. 2189' REPORT

2/13 Spud 2-10-52
8" @ 226'

2/20 Heeb 3421' Tor. 3447' Lans 3461'
Drlg. 3545'

2/27 Spud 2-10-52
D&A TD 3816
8" @ 226
Heeb. 3421 Tor. 3447
Lans. 3461 Arb. 3776
DST 3777-82 open 1 hr. rec. 15' mud
DST 3778-3816 open 1/2 hr. rec. 215'
muddy sw TD 3816
D&A

ABANDONED

County **Rooks** State **Kansas**

Sec. **24** (Blk. Twp.) **10** (Sur. Rge.) **20W** Map No.

Operator **Gulf Oil**

Well No. **1** Farm **Sutor (B)**

Elev. Location **C S/2 SW SW**

FIRST REPORT

330 Ft. From **S** Line **SW**

660 Ft. From **W** Line Quarter

Ist. Report **FEB 13 1952**

Completion

Remarks

Spudding Date **2-10-52**

Drilg. Data

8" @ 226

2/13

J. G. McGEHEE

