

Section 24 Township 10 Range 21WWell No. #1 HolzhauerCompany Fred Jones

NORTH

				0			

WEST

EAST

SOUTH

7

Graham KANSAS

SEC.	TWP.	R.
24	10	21 W ✓

WELL NO. _____

1 Holzhauer FARM

COMPANY _____

Fred Jones

CONTRACTOR _____

J-S-F

White Pool


_____ Ft. from N. Line

330 _____ Ft. from S. Line

_____ Ft. from E. Line

330 _____ Ft. from W. Line

SW SW NE

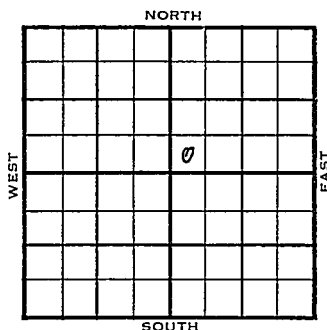

1954	ELEVATION 2211'	REPORT
------	--------------------	--------

5/19

Location

6/2

Spud 5-19-54

D&A

TD 3815'

8" @ 175'

Anhy 1674', Heeb 3437', Tor 3460',

Lans 3478', Cong 3788', Arb. 3804'

DST 3805-10', opn 1/2 hrs., rec. 15' mud


0 #

TD 3815'

D&A

ABANDONED

J. G. McGEHEE

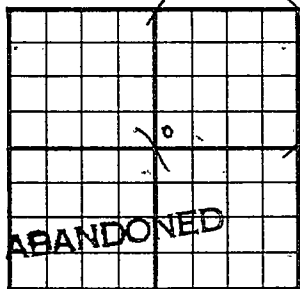County Graham State KansasSec. 24 (Blk. Twp.) 10 (Sur. Rge.) 21W Map No. Operator Fred JonesWell No. 1 Farm HolzhauerElev. 2211 Location SW SW NE

330 Ft. From S Line NE

330 Ft. From W Line Quarter

1st. Report

Completion JUN 2 1954Remarks White PoolJ-S-F - Contr.Spudding Date 5-19-54Drlg. Data D & A TD 38158" @ 175 Anhy 1674 Heeb. 3437Tor. 3460 Lans. 3478 Cong. 3788Arb. 3804 DST 3805-10 open $\frac{1}{2}$ hr.Rec. 15' mud 0# TD 3815D & A