


Section 24 Township 10 Range 21-W

Well No. #1 Klewar

Company Anderson-Prichard etal.
Wildcat

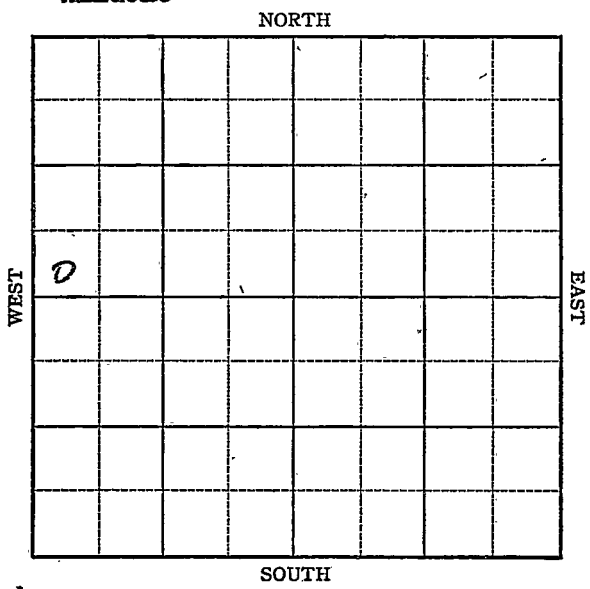

Sec. 24 Twp. 10 R. 21-W

Well No. #1 Klewer Farm

Anderson-Prichard et al. Company

Wildcat


_____ Ft. from N. Line

330 Ft. from S. Line

_____ Ft. from E. Line

330 Ft. from W. Line

SW NW

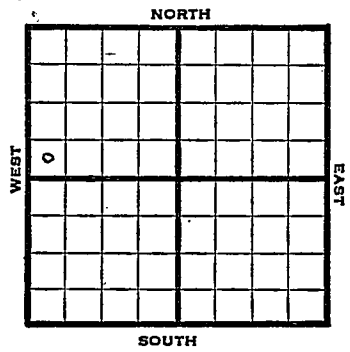

1947

Elev. 2190' REPORT

6/18

Location

6/24

8" @ 254'
WOC

7/1

Drlg 3310'

7/9

Lans. 3435'
Cong. 3757'
Arb. 3755'
TD 3870'

ABANDONED

Map No. _____ Sec. 24 Twp. 10 R. 21W

Well No. 1 Klewer

Anderson-Prichard et al. Company

FIRST REPORT Contractor

SW NW

SECTION PLAT

_____ Ft. from N. Line

330 Ft. from S. Line

_____ Ft. from E. Line

330 Ft. from W. Line

Graham County

Location X

Rig up _____

Drilling and Remarks:

RECORD

Cased _____ in., _____ ft.

Sand _____

Gas _____

Oil _____

Total Depth _____

PRODUCTION

1st 24 hrs. Nat. _____

1st 24 hrs. after shot _____

Gas _____ Cu. Ft.

Dry Hole _____

Abandoned _____

Date

JUN 18 1947

19

S. J. LEWIS

Scout

