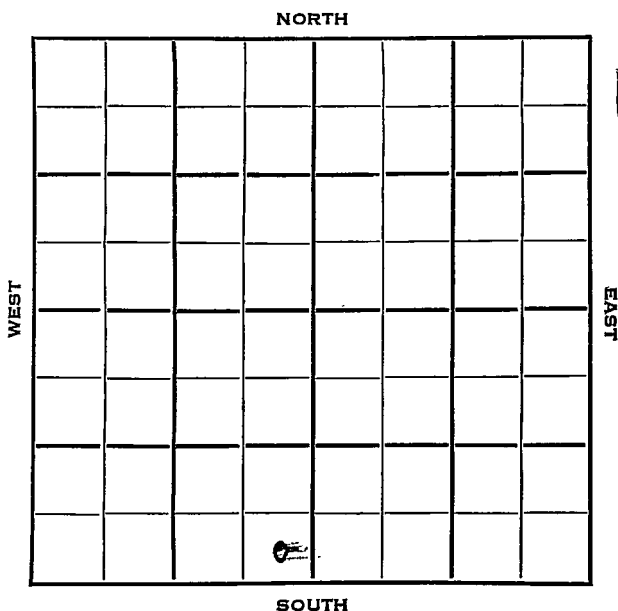


Section 24 Township 10 Range 21WWell No. 1 AtchinsonCompany Anderson-Prichard

Graham

KANSAS

SEC.	TWP.	R.
24	10	21 W ✓
WELL NO.		
# 1 Atchinson		FARM
COMPANY		
Anderson-P Richard		
CONTRACTOR		

White Pool


Ft. from N. Line

330 Ft. from S. Line

330 Ft. from E. Line

Ft. from W. Line

SE SE SW

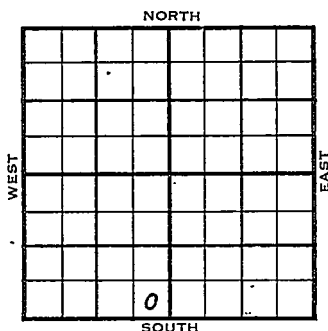

1954	ELEVATION 2178 : REPORT
2/17	Location
2/24	"
3/10	8" @ 228 w/175 Heeb 3399 Tor 3424' Lans 3441' DST 3434-64, 1/2 hr, 15' M 1090# Drlg. 3535'
3/17	DST 3581-3620, 1 hr, 180' Hlg OCM 1090# Arb. 3767' RTD 3770 Schl 5" @ 3769
3/24	DD 3791', NS DD 3823 S/1 BWPH PB 3710 36/3619-25 S/1/2 BOPH 4 hrs. 500 A S/56 BO 10 hrs.
3/31	NR
4/14	Spud 3-2-54 Oil Well TD 3823' 8" @ 228' Heeb 3399', Tor 3424', Lans 3441' DST 3434-64' opn 1/2 hr, rec 15' Mud 1090# DST 3581'-3630' opn 1 hr, rec 180' hocom 1090# Arb 3767' TD 3770' 5" @ 3769'

OVER


1954

Information brought forward.

4/14 DD 3791'
DD 3823 S/ 1 bwph PB 3710'
36/ 3619-25 S/ $\frac{1}{2}$ boph 4 hr. 500 A
S/ 56 bo 10 hr.
P/ 74 bo 3% Wtr.
Comp 90 bopd.

COMPLETED

J. G. McGEHEE

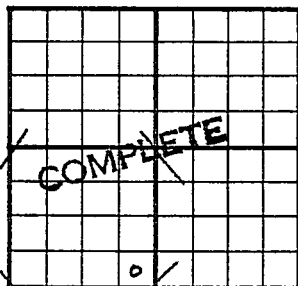County Graham State KansasSec. 24 (Blk. 10 (Sur. 21W Map No. 10)Operator Anderson-PrichardWell No. 1 Farm AtchinsonElev. 2178 Location SE SE SW330 Ft. From S Line SW330 Ft. From E Line Quarter1st. Report .Completion APR 14 1954Remarks White PoolSpudding Date. 3-2-54Drlg. Data Oil well TD 38238" @ 228 Heeb. 3399 Tor. 3424Lans. 3441 DST 3434-64 open $\frac{1}{2}$ hr.Rec. 15' mud 1090# DST 3581-3630open 1 hr. Rec. 180' hocm 1090#Arb. 3767 TD 3770 5" @ 3769 DD 3791DD 3823 S/ 1 bwph PB 3710 36/ 3619-25S/ $\frac{1}{2}$ boph 4 hr. 500 A S/ 56 bo 10 hr.P/ 74 bo 3% wtr. Comp. 90 bopd

J. G. McGEHEE