


Graham

FORM 51

Section 24 Township 10 Range 2 W **KANSAS**

Well No. #2 Acheson

Company Anderson-Prichard

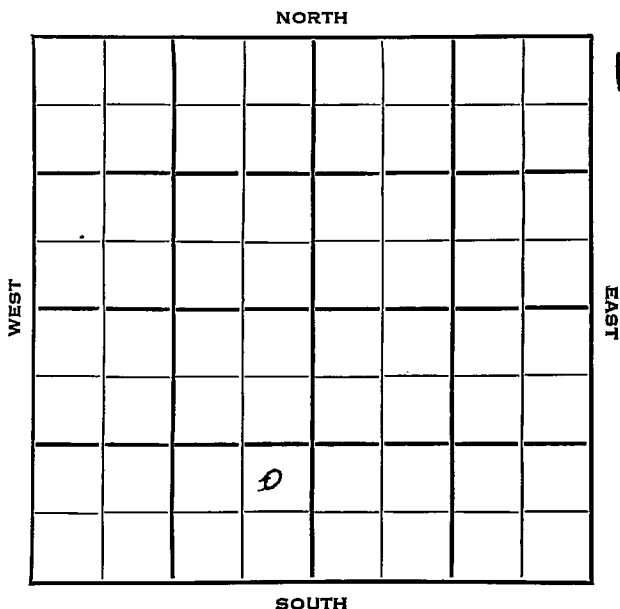

Graham

SEC.	TWP.	R.
24	10	KANSAS 21W

WELL NO.

#2 Atcheson

COMPANY FARM

Anderson-Prichard

CONTRACTOR

Glenn Peel

White Pool


_____ Ft. from N. Line

990 _____ Ft. from S. Line

330 _____ Ft. from E. Line

_____ Ft. from W. Line

NE SE SW

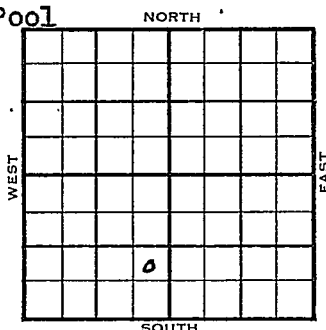

	ELEVATION	REPORT
1954	2192'	

4/7
4/14

Location
"

5/19

Spud 4-8-54 Oil well TD 3754
 8-5/8" @ 255 Heeb 3408 Tor 3433
 Lans. 3449 B KC 3678 Cong 3722
 Arb. 3749
 DST 3750-54 open 1 hr rec 55' oil
 50' HOCM 765# 5" @ 3750
 Co to 3754 S/84 BO 5 hr.
 P/217 BO 23 hr.
 Comp. 265 BOPD

COMPLETED

County **Graham** State **Kansas**
 Sec. **24** (Blk. Twp.) **10** (Sur. Rge.) **21W** Map No.
 Operator **Anderson-Prichard**
 Well No. **2** Farm **Atcheson**
 Elev. Location **NE SE SW**

990 Ft. From **S** Line **SW**

330 Ft. From **E** Line Quarter

1st. Report **APR 7 1954**

Completion

Remarks

Glenn Peel - Contr.

Spudding Date

Drig. Data

White Pool

Location

J. G. McGEHEE

County	Graham		State	Kansas
Sec.	24	(Blk. Twp.) 10	(Sur. Rge.) 21W	Map No.
Operator	Anderson-Prichard			
Well No.	2	Farm	Atcheson	
Elev.	2192	Location	NE SE SW	

[illegible]

990 Ft. From S Line SW

330 Ft. From E Line Quarter

1st. Report

Completion MAY 19 1954

Remarks	White Pool
---------	------------

Glenn Peel - Contr.

Spudding Date 4-8-54

Drilg. Data Oil well TD 3754

8 5/8" @ 255 Heeb. 3408 Tor. 3433

Lans. 3449 B KC 3678 Cong. 3722

Arb. 3749 DST 3750-54 open 1 hr.

Rec. 55' oil 50' hocm 765# 5" @ 3750

CO to 3754 S/ 84 bo 5 hr. P/ 217 bo

23 hr. Comp. 265 bopd

J. G. McGEHEE