


Section 24 Township 10 Range 21 W
Well No. # 2 Schmahlfeldt
Company Petroleum Inc.

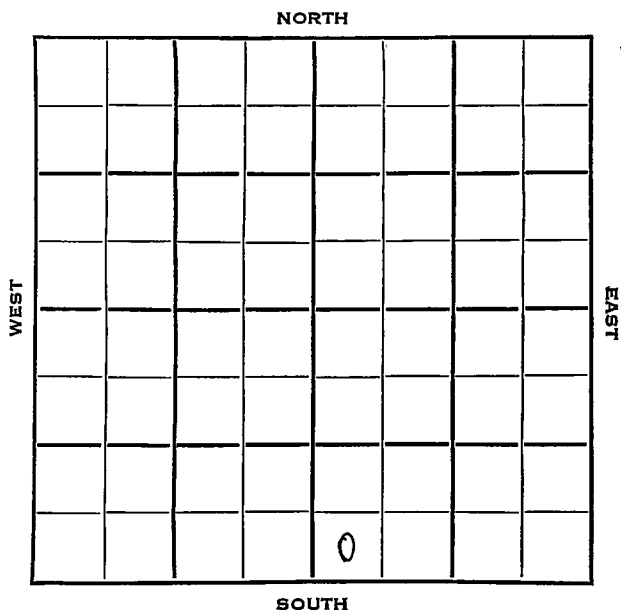

Graham KANSAS

SEC.	TWP.	R.
24	10	21W ✓

WELL NO.

2 Schmahlfeldt

FARM

COMPANY

Petroleum, Inc.

CONTRACTOR

Lewis Drlg.

Wildcat


_____ Ft. from N. Line

330 _____ Ft. from S. Line

_____ Ft. from E. Line

330 _____ Ft. from W. Line

SW SW SE

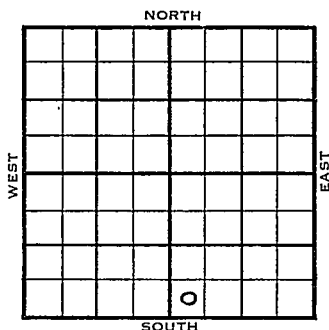

	ELEVATION	REPORT
1953	2193'	
12/30	Spud 12-24-53 8" @ 164' Drlg. 2240'	
1954 1/6	Heeb 3391 Tor 3418 Lans 3432 Drlg. 3605'	
1/13	DST 3513-38, 1 hr, 620' SW 980# DST 3583-3623, 1 hr, 570' MCO 1145# Arb. 3736' RTD 3741' 5" @ 3737	
1/20	DD 3743' TD 1500A S/7½ boph	
1/27	NR	
2/10	NR	
2/24	Spud 12-24-53 Oil Well TD 3743' 8" @ 164' Heeb 3391', Tor 3418', Lans 3432' DST 3513-38', opnl hr., rec. 620' sw, 980# DST 3583-3623', opnl 1 hr., rec. 570' mco, 1145# Arb. 3736'	

1954 (Information Brought Forward)

2/24

TD 3741'

5" @ 3737'

DD 3743' 1500A.

S/7 $\frac{1}{2}$ boph

Comp. 1275 bopd

COMPLETED

J. G. McGEHEE

J. G. McGEHEE