


Section 24 Township 10 Range 21W

Well No. 4 Atchison

Company Anderson-Prichard

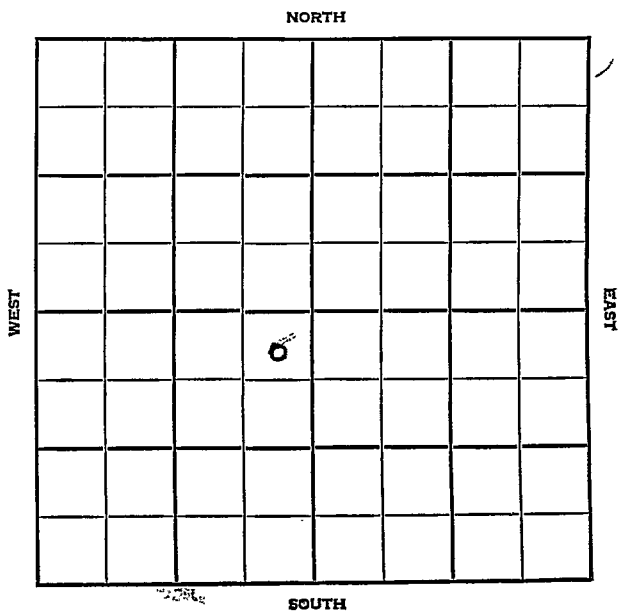

XXI Graham KANSAS

SEC. 24 TWP. 10 R. 21W ✓

WELL NO. 4 Atchison FARM COMPANY

Anderson-Prichard CONTRACTOR

Peel Drlg.- Contr


White Pool

330 Ft. from N. Line

Ft. from S. Line

330 Ft. from E. Line

Ft. from W. Line

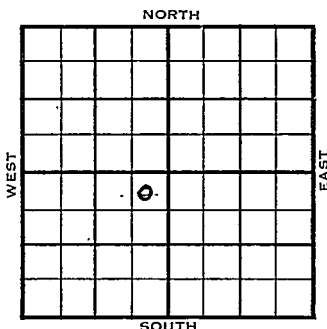

NE NE SW

ELEVATION

REPORT

1954 2199

6/2

Drlg.

6/9 8" @ 224 Top. 3211 Heeb 3414'
 Tor. 3439' Lans 3455
 DST 3607-39, 1 hr, 60' hly OCM, 900'
 M & GCO 1090# B KC 3677
 Cong. 3727' Simp. 3741' Arb. 3754
 RTD 3758 5" @ 3756

6/23

CO 3758'
 S/9 boph 8 hrs.

6/30

Spudding 5-30-54
 Oil well
 TD 3758
 8" @ 224
 Top 3211 Heeb 3414 Tor 3439
 Lans. 3455
 DST 3607-39open 1 hr. Rec. 60' hocm
 900' mud & gco 1090#
 BKC 3677 Cong. 3727 Simp 3741
 Arb 3754
 TD 3758
 5" @ 3756 CO to 3758 S/ 9 boph 8 hr
 Comp 207 bopd.

COMPLETED

County Graham State Kansas

Sec. 24 (Blk. 10) (Sur. 21W) (Twp.) (Rge.) Map No.

Operator Anderson-Prichard

Well No. 4 Farm Atchison

Elev. 2199 Location NE NE SW

COMPLETE					

330 Ft. From N Line SW

330 Ft. From E Line Quarter

1st. Report

Completion JUN 30 1954

Remarks White Pool

Peel Drlg. - Contr.

Spudding Date 5-30-54

Drlg. Data Oil well TD 3758

8" @ 224 Top. 3211 Heeb. 3414

Tor. 3439 Lans. 3455 DST 3607-39

open 1 hr. Rec. 60' hocm 900' mud &

gco 1090# B KC 3677 Cong. 3727

Simp. 3741 Arb. 3754 TD 3758

5" @ 3756 CO to 3758 S/ 9 boph 8 hr.

Comp. 207 bopd