

Graham KANSAS

SEC. 24	TWP. 10	R. 21W ✓
------------	------------	-------------

WELL NO. 6 Atcheson FARM

COMPANY Anderson-Prichard

CONTRACTOR Peel


White Pool

990 Ft. from N. Line

Ft. from S. Line

Ft. from E. Line

330 Ft. from W. Line

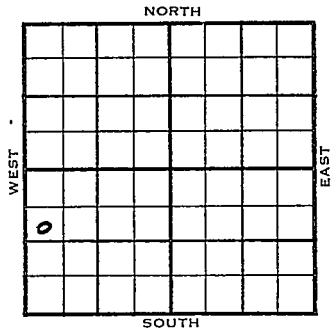

SW NW SW

1954	ELEVATION 2179'	REPORT
------	--------------------	--------

6/23 Location
 6/30 8" @ 245' w/175 sks
 Drlg. 3090'
 7/7 Spud 6-24-54
 D&A
 TD 3778'
 8" @ 245'
 Heeb 3411', Tor 3434', Lans 3452'
 DST 3591-3636', opn 3/4 hrs., rec. 10'
 SOCM, 0#
 DST 3767-3772', opn 3/4 hr., rec.
 20' mud, 300#
 DST 3767-78', opn 3/4 hr., rec. 28'
 mud, 200#
 Cong 3730', Arb. 3765'
 TD 3778'
 D&A

ABANDONED

