

Section 24 Township 10 Range 22<sup>W</sup>  
~~23<sup>W</sup>~~Well No. ~~#~~  
~~#~~ SutorCompany Jones Shelburne & Farmer

NORTH

|  |  |  |  |  |  |  |   |
|--|--|--|--|--|--|--|---|
|  |  |  |  |  |  |  | 0 |
|  |  |  |  |  |  |  |   |
|  |  |  |  |  |  |  |   |
SOUTH

WEST

EAST

Graham

KANSAS

22W  
21W

Sec. 24 Twp. 10 R. 21W

Well No. #7 Sutor Farm

Jones Shelburne & Farmer Company

Contractor


330' Morlan  
Ft. from N. Line

Ft. from S. Line

330' Ft. from E. Line

Ft. from W. Line

NE NE NE

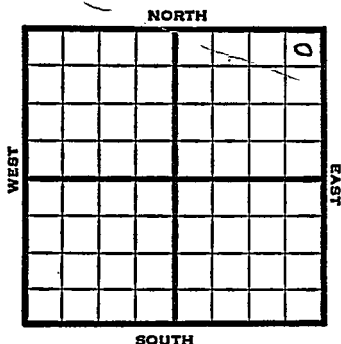

1951 Elev. 2274' REPORT

10/17 Location

11/7 Spud 10-22-51  
D&A TD 4000  
8" @ 158  
Anhy 1780  
KC 3555  
Cong. 3915  
TD 4000  
D&A

Heeb. 3525  
B KØ 3800  
Arb. 3986

**ABANDONED**

J. E. TYRA

*jk*  
**CORRECTION**

Map No. \_\_\_\_\_ Sec. 24 Twp. 10 R. 22 WWell No. 1 Sutor

Jones Shelburne &amp; Farmer \_\_\_\_\_ Company

\_\_\_\_\_  
Contractor

NE NE NE

## SECTION PLAT

330 Ft. from N. Line

\_\_\_\_\_ Ft. from S. Line

330 Ft. from E. Line

\_\_\_\_\_ Ft. from W. Line

|                   |  |  |  |
|-------------------|--|--|--|
| ○                 |  |  |  |
| <b>CORRECTION</b> |  |  |  |
|                   |  |  |  |
|                   |  |  |  |

Graham County, Kansas

Location \_\_\_\_\_

Rig up \_\_\_\_\_

Drilling and Remarks:

Reported as  
# 7 Sutor

in Section 24-  
10S-21W

## RECORD

Cased \_\_\_\_\_ in., \_\_\_\_\_ ft.

Sand \_\_\_\_\_

Gas \_\_\_\_\_

Oil \_\_\_\_\_

Total Depth \_\_\_\_\_

## PRODUCTION

1st 24 hrs. Nat. \_\_\_\_\_

1st 24 hrs. after shot \_\_\_\_\_

Gas \_\_\_\_\_ Cu. Ft.

Dry Hole \_\_\_\_\_

Abandoned \_\_\_\_\_

Date

Oct., 25, 1951

J. E. Tyra

Kansas

Map No. \_\_\_\_\_ Sec. 24 Twp. 10 R. 22W

Well No. 1 Sutor

Jones, Shelborne & Farmer Company

**CORRECTION**

Contractor

NE NE NE

SECTION PLAT

330 Ft. from N. Line

\_\_\_\_\_ Ft. from S. Line

330 Ft. from E. Line

\_\_\_\_\_ Ft. from W. Line

|  |  |  |   |
|--|--|--|---|
|  |  |  | o |
|  |  |  |   |
|  |  |  |   |
|  |  |  |   |

Graham County

Location \_\_\_\_\_

Rig up \_\_\_\_\_

Drilling and Remarks:

Reported  
#7 Sutor  
24-10-21W

RECORD

Cased \_\_\_\_\_ in., \_\_\_\_\_ ft.

Sand \_\_\_\_\_

Gas \_\_\_\_\_

Oil \_\_\_\_\_

Total Depth \_\_\_\_\_

PRODUCTION

1st 24 hrs. Nat. \_\_\_\_\_

1st 24 hrs. after shot \_\_\_\_\_

Gas \_\_\_\_\_ Cu. Ft.

Dry Hole \_\_\_\_\_

Abandoned \_\_\_\_\_

Date


NOV 7 1951

19

J. E. TYRA

Scout

County Graham State Kansas  
 Sec. 24 (Blk.) 10 (Sur.) 22W Map No.             
 Operator Jones, Shelborne & Farmer  
 Well No. 1 Farm Sutor  
 Elev. 2274 Location NE NE NE

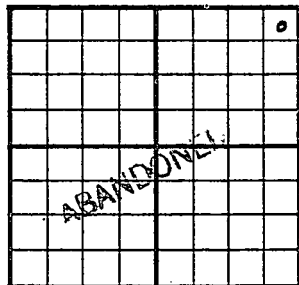

330 Ft. From N Line NE

330 Ft. From E Line Quarter

1st. Report

Completion NOV 7 1951

Remarks Morlan Pool

Spudding Date 10-22-51

Drlg. Data D &amp; A TD 4000

8" @ 158 Anhy 1780 Heeb. 3525

KC 3555 B KC 3800 Cong. 3915

Arb. 3986 TD 4000

D &amp; A

J. E. TYRA