



STATE CORPORATION COMMISSION OF KANSAS
OIL & GAS CONSERVATION DIVISION

WELL COMPLETION OR RECOMPLETION FORM
ACO-1 WELL HISTORY

DESCRIPTION OF WELL AND LEASE

Operator: license # 9067
name DaMar Resources, Inc.
address P. O. Box 70
City/State/Zip Hays, KS 67601

Operator Contact Person Dan Schippers
Phone 913-625-0020

Contractor: license # 8241
name Emphasis Oil Operations

Wellsite Geologist Jerry Green
Phone (913) 625-5155

PURCHASER

Designate Type of Completion
 New Well Re-Entry Workover

- Oil SWD Temp Abd
- Gas Inj Delayed Comp.
- Dry Other (Core, Water Supply etc.)

If OWWO: old well info as follows:

Operator
Well Name
Comp. Date Old Total Depth

WELL HISTORY

Drilling Method: Mud Rotary Air Rotary Cable
8-01-84 8-08-84 8-08-84
Date Date Reached TD Completion Date

4100' RTD
Total Depth PBTD

Point of Surface Pipe Set and Cemented at 246' feet

Multiple Stage Cementing Collar Used? Yes No

If Yes, Show Depth Set feet

If alternate 2 completion, cement circulated from feet depth to w/ SX cmt

Wireline Log Rec'd

API NO. 15 - 065-22,025 30-10-24W

County Graham
50'S & 60'E
SW NE SW Sec 30 Twp 10S Rge 24 East XX West
(location)

1600 Ft North from Southeast Corner of Section
3570 Ft West from Southeast Corner of Section
(Note: locate well in section plat below)


Lease Name Gano Well# 1

Field Name

Producing Formation

Elevation: Ground 2481 KB 2486

Section Plat

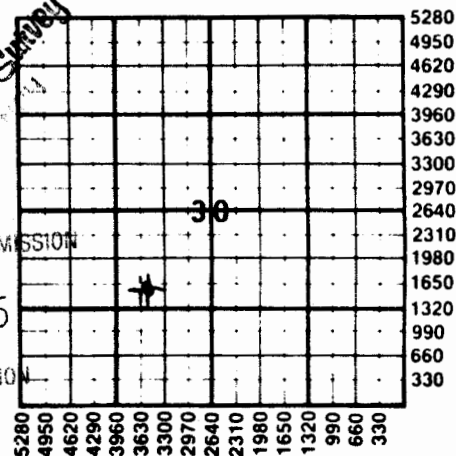

MAY 2 2 1985
State Geological Survey
STATE CORPORATION COMMISSION
MAY 1 4 1985
CONSERVATION DIVISION
Wichita, Kansas

WATER SUPPLY INFORMATION

Source of Water:
Division of Water Resources Permit #

Groundwater Ft North From Southeast Corner and (Well) Ft West From Southeast Corner of Sec Twp Rge East West

Surface Water 990 Ft North From Southeast Corner and (Stream, Pond etc.) 330 Ft West From Southeast Corner Sec 15 Twp 10S Rge 25 East XX West

Other (explain) (purchased from city, R.W.D.#)

Disposition of Produced Water: Disposal Repressuring

Docket #

INSTRUCTIONS: This form shall be completed in duplicate and filed with the Kansas Corporation Commission, 200 Colorado Derby Building, Wichita, Kansas 67202, within 90 days after completion or recompletion of any well. Rules 82-3-130 and 82-3-107 apply.

Information on side two of this form will be held confidential for a period of 12 months if requested in writing and submitted with the form. See rule 82-3-107 for confidentiality in excess of 12 months.

A copy of all wireline logs and drillers time log shall be attached with this form. Submit CP-4 form with all plugged wells. Submit CP-111 form with temporarily abandoned wells.

Operator Name **Damar Resources, Inc.** Lease Name **Gano** Well# **1** SEC **30** TWP. **10S** RGE. **24** East West

WELL LOG

INSTRUCTIONS: Show important tops and base of formations penetrated. Detail all cores. Report all drill stem tests giving interval tested, time tool open and closed, flowing and shut-in pressures, whether shut-in pressure reached static level, hydrostatic pressures, bottom hole temperature, fluid recovery, and flow rates if gas to surface during test. Attach extra sheet if more space is needed. Attach copy of log.

Drill Stem Tests Taken Yes No
 Samples Sent to Geological Survey Yes No
 Cores Taken Yes No

Formation Description
 Log Sample

DST #1: 3846-3872 (B)
 60-45-30-45
 ISIP - 1095
 FSIP - 1084
 IFP - 51-92
 FFP - 102-112
 Recovery: 1' oil, 4' OCM and 125' WM

Name	Top	Bottom
Topeka	3566	(-1080)
Heebner	3793	(-1307)
Toronto	3814	(-1328)
Lansing-K.C.	3828	(-1342)
Lansing-K.C. Base	4078	(-1592)
R.T.D.	4100	(-1614)
L.T.D.	4101	(-1615)

CASING RECORD <input checked="" type="checkbox"/> new <input type="checkbox"/> used							
Report all strings set - conductor, surface, intermediate, production, etc.							
Purpose of string	size hole drilled	size casing set (in O.D.)	weight lbs/ft.	setting depth	type of cement	# sacks used	type and percent additives
Surface	12 1/4"	8 5/8"	23#	246'	Common	170	3% cc, 2% gel
PERFORATION RECORD				Acid, Fracture, Shot, Cement Squeeze Record			
shots per foot	specify footage of each interval perforated			(amount and kind of material used)			Depth