

33-10-24Wd

STATE CORPORATION COMMISSION OF KANSAS
OIL & GAS CONSERVATION DIVISION
WELL COMPLETION OR RECOMPLETION FORM
ACO-1 WELL HISTORY
DESCRIPTION OF WELL AND LEASE

Operator: License # 6875
Name Marmik Oil Company
Address 200 N. Jefferson, #500
City/State/Zip Eldorado, AR 71730

Purchaser

Operator Contact Person Curt Morrill
Phone 501-862-8546

Contractor: License # 5422
Name Abercrombie Drilling, Inc.

Wellsite Geologist Curtis G. Morrill
Phone 501-862-5421

Designate Type of Completion
 New Well Re-Entry Workover

Oil SWD Temp Abd
 Gas Inj Delayed Comp.
 Dry Other (Core, Water Supply etc.)

If OWWO: old well info as follows:
Operator
Well Name
Comp. Date Old Total Depth

WELL HISTORY

Drilling Method:
 Mud Rotary Air Rotary Cable

3-7-87 3-14-87 4-23-87
Spud Date Date Reached TD Completion Date

3950'
Total Depth PBDT

Amount of Surface Pipe Set and Cemented at 259 feet
Multiple Stage Cementing Collar Used? Yes No
If yes, show depth set feet
If alternate 2 completion, cement circulated from feet depth to w/ SX cmt
Cement Company Name
Invoice #

API NO. 15-065-22,355
County Graham
E/2 NE SE Sec. 33 Twp. 10 Rge. 24 East West

1980 Ft North from Southeast Corner of Section
330 Ft West from Southeast Corner of Section
(Note: Locate well in section plat below)


Lease Name Alfrida Well # 1

Field Name Mary Hanna

Producing Formation

Elevation: Ground 2355 KB 2360

Section Plat

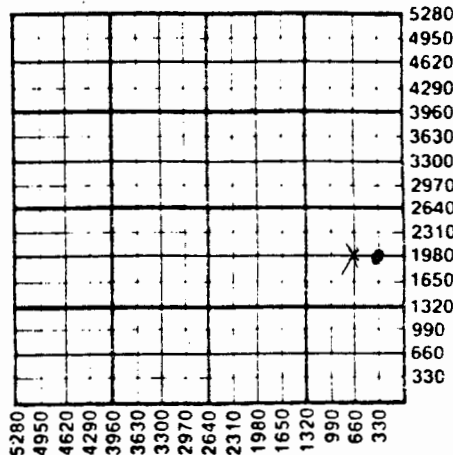

WATER SUPPLY INFORMATION

Disposition of Produced Water: Disposal
Docket # Repressuring

Questions on this portion of the ACO-1 call:

Water Resources Board (913) 296-3717

Source of Water:
Division of Water Resources Permit #

Groundwater Ft North from Southeast Corner
(Well) Ft West from Southeast Corner of
Sec Twp Rge East West

X Surface Water 4950 Ft North from Southeast Corner
2640 Ft West from Southeast Corner
Sec 10 Twp 11 Rge 24 East X West
Trego County

X Other (explain) Dean Hollandworth
(purchased from city, R.W.D. #)

INSTRUCTIONS: This form shall be completed in triplicate and filed with the Kansas Corporation Commission, 200 Colorado Derby Building, Wichita, Kansas 67202, within 120 days of the spud date of any well. Rule 82-3-130, 82-3-107 and 82-3-106 apply.
Information on side two of this form will be held confidential for a period of 12 months if requested in writing and submitted with the form. See rule 82-3-107 for confidentiality in excess of 12 months.
One copy of all wireline logs and drillers time log shall be attached with this form. Submit CP-4 form with all plugged wells. Submit CP-111 form with all temporarily abandoned wells.