

Section 25 Township 10 Range 23 W

Well No. #2 Griffith

Company Colorado Oil & Gas

NORTH

									0

SOUTH

WEST

EAST

Graham

KANSAS

SEC.	TWP.	R.
25	10	23W

WELL NO.

#2 Griffith

FARM

COMPANY

Colorado Oil & Gas

CONTRACTOR

Glen Peel

Prairie Glen


\_\_\_\_\_ Ft. from N. Line

\_\_\_\_\_ Ft. from S. Line

\_\_\_\_\_ Ft. from E. Line

\_\_\_\_\_ Ft. from W. Line

SE SE SE

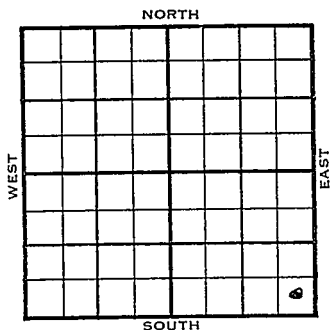

1955

ELEVATION  
2302'

REPORT

FIRST REPORT

8/10

Comm 8-5-55  
8" @194/175 Drlg: 2415

8/17

DST 3748-65 open 1½ hr. 120' gip Rec.  
30' ho & gcm plus 45' o & gcm plus 45'  
vssmw BHP 1240# 30" DS. 3775-3808 open  
1½ hr. 423' sw BHP 1220# 30" D&A  
H: 3542, 1240, Tr: 3565, 1263, L: 3579,  
1277, BKC: 3804, 1502, TD: 3808.

**ABANDONED**

County Graham Elev. 2302

Sec. 25 Twp. 10 Rge. 2 3W

Company Colorado Oil & Gas

Farm Name Griffith No. 2

Co.

TOPS	DEPTH	LOG	DATUM
Anh.			
Tr.			
H.			
Tr.			
Dg.			
Bl.			
L.			
K.C.			
B.K.C.			
Ce.			
C.			
M.			
M.			
K.			
Mz.			
Me.			
V.			
S.			
S.			
A.			
R.			
PE.			
G.			
T.D.			

Loc. in Sec. \_\_\_\_\_

SE SE SE

Geol. \_\_\_\_\_

Contr. \_\_\_\_\_

Glen Peel

Pool \_\_\_\_\_

Prairie Glen

AUG 10 '59	
<b>FIELD REPORT</b>	
	0

Loc.

No.

Sec.

T.

R.

Date Comm. 8-5-55

8" @ 194/175 drlg. 2415

County Graham Elev. 2302  
 Sec. 25 Twp. 10S Rge. 23W  
 Company Colorado Oil & Gas  
 Farm Name Griffith No. 2

TOPS	DEPTH	LOG	DATUM
Anh.			
TP.			
H.		3542	1240
Tr.		3565	1263
Dg.			
BL.			
L.		3579	1277
K.C.			
B.K.C.	3804		1502
Ce.			
C.			
M.			
M.			
K.			
Mz.			
Ma.			
V.			
S.			
S.			
A.			
R.			
PE.			
G.			
T.D.	3808		

Loc. in Sec. SE SE SE  
 Geol. \_\_\_\_\_  
 Contr. Glen Peel  
 Pool Prairie Glen

**ABANDONED**  
 AUG 17 1955  
 0

Date Comm. 8/5/55 8" 195 w/175  
DST 3748-65 open 1 1/2 hr 120' gip Rec. 30'  
ho & gcm plus 45' o & gcm plus 45' vssmw  
BHP 1240# 30" DST 3775-3808 open 1 1/2 hr  
423' sw BHP 1220# 30"

D& A

Co. No. 2  
 Sec. No. 25  
 Twp. No. 10  
 R. No. 23