


Graham KANSAS

Section 25 Township 10 Range 23W

Well No. 1 McCall "B"

Company Petroleum, Inc.

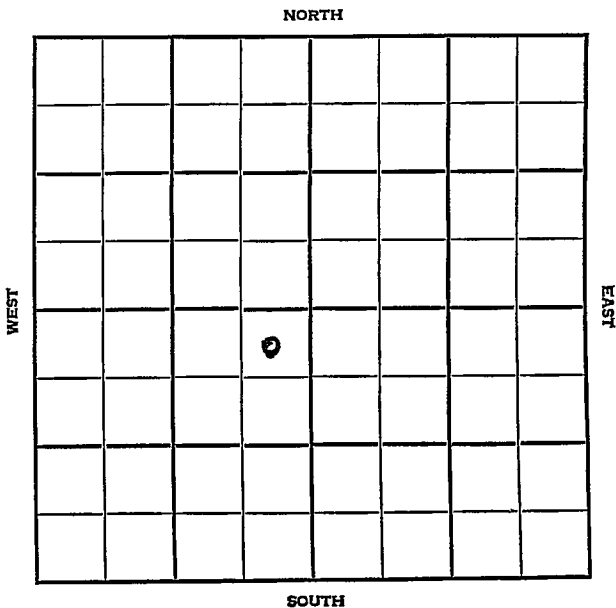

Graham

KANSAS

SEC.	TWP.	R.
25	10	23 W
WELL NO.		
# 1 McCall "B"		
FARM		
COMPANY		
Petroleum Inc.		
CONTRACTOR		

Garvey

Wildcat


330 Ft. from N. Line

Ft. from S. Line

330 Ft. from E. Line

Ft. from W. Line

NE NE SW

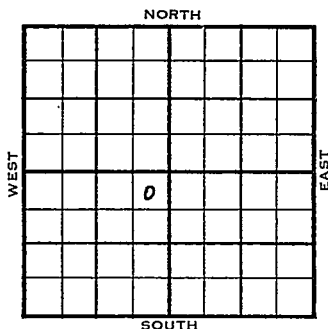

	ELEVATION	REPORT
1954	2327'	
10/20	Spud 10-18-54 8" @ 208 WOC	
11/22	Spud 10-18-54 Oil Well TD 4145' 8" @ 208' Anhy 1827' Heeb 3558' Tor 3578' Lans 3591' DST 3593'-3670' opn 1 hr, rec 242' gas & ocwm 60' ho & gcwm, 420' wtry oil 1150# DST 3629'-36' opn 1 hr, rec 30' ocm 0# DST 3635'-70' opn 40 min, rec 5' Mud 0# DST 3673'-3749' opn 1 hr, rec 990' gas, rec 265' Muddy wtr. 1050# DST 3745'-3825' opn 1 hr, rec 180' o & gcm, 950# Cong 4001' DST 3927'-4030' opn 1 hr, rec 30' Mud 500# Simp 4090' Arb. 4120' TD 4145' 5" @ 3845' 15/ 3792'-97' 1500 A S/ 4 bfph 40% Wtr PB 3786' 32/ 3769-77 S/ 3 bfph 50% Wtr. 250 A S/ 3½ bfph 50% Wtr. PB 363	

1954

Information brought forward.


11/22

17/ 3596-3600 S/ 5 go 10 gwph
S/ 8 bfph 8 hr. 45% Wtr. P/ 200 bopd
45% Wtr.
Comp 93 bopd. 20% Wtr.

COMPLETED

FABEN GILSTRAP

County Graham State Kansas
 Sec. 25 (Blk.) 10 (Sur.) 23W Map No.
 Operator Petroleum Inc.
 Well No. 1 Farm McCall "B"
 Elev. 2327 Location NE NE SW

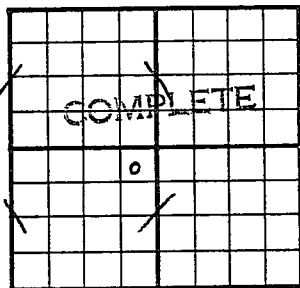

330 Ft. From N Line SW
330 Ft. From E Line Quarter
 Ist. Report
 Completion DEC 22 1954
 Remarks Wildcat
Garvey - Contr.
 Spudding Date 10-18-54

Drig. Data Oil well TD 4145
8" @ 208 Anhy 1827 Heeb. 3558
Tor. 3578 Lans. 3591 DST 3593-3670
open 1 hr. Rec. 242' gas & ocwm
60' ho & gcwm 420' wtry oil 1150#
DST 3629-36 open 1 hr. Rec. 30' ocm
0# DST 3635-70 open 40 min. Rec. 5' mud
0# DST 3673-3749 open 1 hr. Rec.
990' gas Rec. 265' muddy wtr. 1050#
DST 3745-3825 open 1 hr. Rec. 180' o &
gcm 950# Cong. 4001 DST 3927-4030
open 1 hr. Rec. 30' mud 500#
Simp. 4090 Arb. 4120 TD 4145
5" @ 3845 15/ 3792-97 1500 A
* S/ 4 bfph 40% wtr. PB 3786

FABEN GILSTRAP

Drig. Data

32/ 3769-77 S/ 3 bfph 50% wtr. 250 A

S/ $3\frac{1}{2}$ bfph 50% wtr. PB 3632

17/ 3596-3600 S/ 5 go 10/gwph

S/ 8 bfph 8 hr. 45% wtr. P/-200 bopd

45% wtr. Comp. 93 bopd 20% wtr.

DEC 29 1954