

DX 78-1

Section 25 Township 10 Range 23W
Well No. #2 McCall "B"
Company Petroleum Inc.

NORTH

WEST

EAST

SOUTH

Graham		KANSAS
SEC.	TWP.	R.
25	10	23 W
WELL NO.		
# 2 McCall "B"		FARM
COMPANY		
Petroleum Inc.		
CONTRACTOR		

Garvey
Prairie Glen Pool


_____ Ft. from N. Line

330 _____ Ft. from S. Line

330 _____ Ft. from E. Line

_____ Ft. from W. Line

SE SE NW

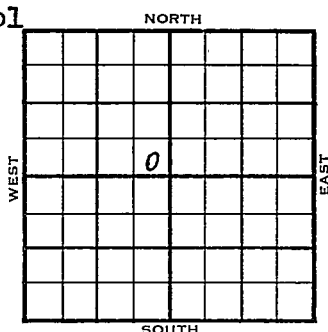

1954	ELEVATION 2330'	REPORT
12/15		Spud 12-18-54 8" @ 202 Anhy 1833 Heeb 3559 Lans. 3599' DST 3585-3603'
1955 2/9		Spud 12-18-54 Oil Well TD 4040' 8" @ 202' Anhy 1833', Heeb 3559' Lans 3599' DST 3585'-3606' opn 1 hr, rec 120' oil & gcm 60' vhoem 240' mo 60' sw. DST 3618'-94' opn 1 hr, rec 300' ho & gcm 200# DST 3747'-3839' opn 50 min, rec 10' Muc O# Cong 3997' TD 4040' 5" @ 3738' 12/ 3673-76 500 A S/ 9 bfph 30% Wtr. 16/ 3635-39 S/ 5 boph 14% Wtr. 500 A S/.14½ bfph 35% Wtr. 23/ 3599-3605 S/ 1 boph 15% Wtr. 500 A S/ 50 bfph mostly oil Comp 242 bopd. 40% Wtr.

COMPLETED

Sec. 25 (Blk.) 10 (Sur.) 23rd Map No.

Well No. **2** Farm **McCall "B"**

Elev.	Location	SE	SE	NF
-------	----------	----	----	----

0

FIRST REPORT

330 Ft. From S Line NW

330 Ft. From E Line Quarter

1st. Report DEC 15 1954

Completion

Remarks:

Garvey - Contr.

Spudding Date **12-18-54**


Drig. Data

8th @ 202 Anhy 1833 Heeb. 3559

Lans. 3599 DST 3585-3603

FABEN GILSTRAP

County Graham State Kansas
 Sec. 25 (Blk. 10) (Sur. 3W) Map No.
 Operator Petroleum Inc.
 Well No. 2 Farm McCall "B"
 Elev. 2330 Location SE SE NW

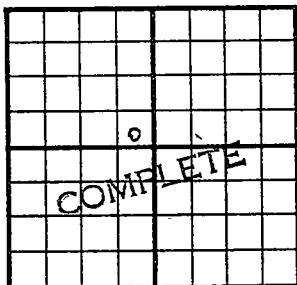

330 Ft. From S Line NW
330 Ft. From E Line Quarter
 Ist. Report
 Completion FEB 9 1955
 Remarks Prairie Glen Pool
Garvey - Contr.
 Spudding Date 12-18-54

Drlg. Data Oil well TD 4040
8" @ 202 Anhy 1833 Heeb. 3559
Lans. 3599 DST 3585-3606 open 1 hr.
Rec. 120' oil & gcm 60' vhoem
240' mo 60' sw DST 3618-94 open 1 hr.
Rec. 300' ho & gcm 200# DST 3747-3839
open 50 min. Rec. 10' mud 0#
Cong. 3997 TD 4040 5" @ 3738
12/ 3673-76 500 A S/ 9 bfph 30% wtr.
16/ 3635-39 S/ 5 boph 14% wtr.
500 A S/ 14 $\frac{1}{2}$ bfph 35% wtr. 23/ 3599-
3605 S/ 1 boph 15% wtr. 500 A
S/ 50 bfph mostly oil
Comp. 242 bopd 40% wtr.

FABEN GILSTRAP