


Section 25 Township 10 Range 24 W

Well No. #1 Billings "A"

Company Musgrove Pet.

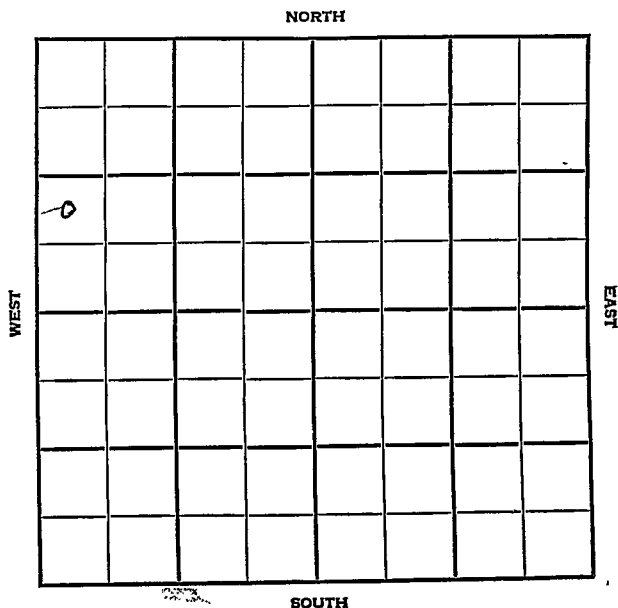

SEC. 25	TWP. 10	R. 24W
------------	------------	-----------

WELL NO.

#1 Billings "A"

FARM

COMPANY

Musgrove Pet.

CONTRACTOR

W. Dorman


Ft. from N. Line

Ft. from S. Line

Ft. from E. Line

Ft. from W. Line

NW SW NW

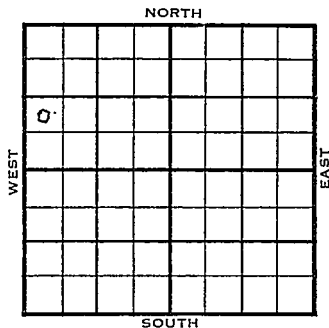

1955

ELEVATION

REPORT

9-14 Comm. 9-8-55
8" @ 208/150
Drlg. 3115'
Anh. 2030'

9/28 Comm 9-8-55
8" @ 208/150

Anh 2030
Tp 3517
H 3732
Tr 3754
L 3770
BKG 4002
TD 4010

DST 3914-39 open 1 hr Rec 30' mud
0/20" DST 3935-64 open 1 hr Rec
210' mud 1150/302 DST 3839-70
open 1 hr Rec 310' so & gcm sw 1210/
D&A

ABANDONED

County Graham Elev. _____
 Sec. 25 Twp. 10 Rge. 2/W
 Company Musgrove Pet.
 Farm Name BILLINGS #A# No. 1

TOPS	DEPTH	LOG	DATUM
Anh.	2030		
TP.			
H.			
Tr.			
Dg.			
BL.			
L.			
K.C.			
B.K.C.			
Ce.			
C.			
M.			
M.			
K.			
Mz.			
Mq.			
V.			
S.			
S.			
A.			
R.			
PE.			
G.			
TR.			

Loc. in Sec. _____
NW SW NW
 Geol. _____
 Contr. _____
 Pool _____
W. Dorman

SEP 4 '55
 FIRST REPORT

Date Comm. 9-8-55
8" @ 208/150 drlg. 3115

Co.
Lse.
No.
Sec.
T.
R.

County Graham Elev. 2112
 Sec. 25 Twp. 30 Rge. 2W.
 Company Musgrove Pet.
 Farm Name Billings "A" No. 1

TOPS	DEPTH	LOG	DATUM	Loc. in Sec.
Anh.	2030			NW SWNW
Tp.	3517		1103	
H.	3735		1320	
Tr.	3754		1345	
Dg.				
Bl.				
L.	3770		1358	Geol.
K.C.				Contr.
B.K.C.	4002		1590	
Ce.				
C.				
M.				
M.				Pool
K.				W. Dorman
Mz.				
Ma.				
V.				
S.				
S.				
A				
R.				
Pe.				
G.				
T.D.	4010			

10
 ABANDONED

Date Comm. 9-8-55 SEP 28 1955

8" @ 208/150 DST 3914-39 open 1 hr.

Rec. 30' mud 0/20" DST 3935-64

open 1 hr. Rec. 210' mud 1150/30"

DS^T 3839-70 open 1 hr. Rec. 310' so &

gcmsw 1210/

D & A